


T.24 S. R.6 & 7 W. W.M.

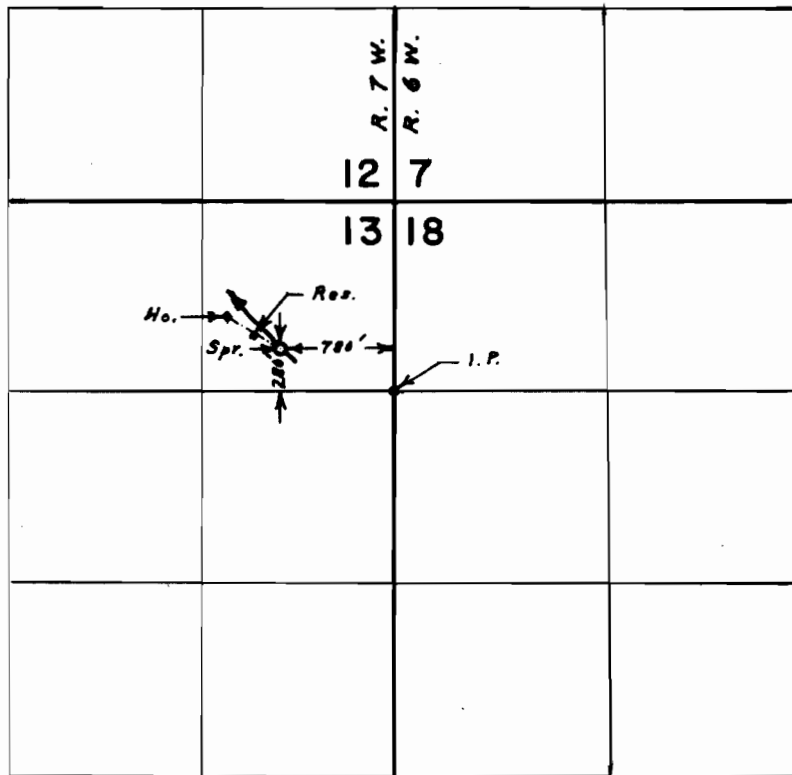

FINAL PROOF SURVEY
UNDER

Application No. 43309 Permit No. 32382
IN NAME OF

STANTON R. SMITH

Surveyed April 3, 1973, by L. E. Gould