


T. 24S. R. 7 W. W.M.

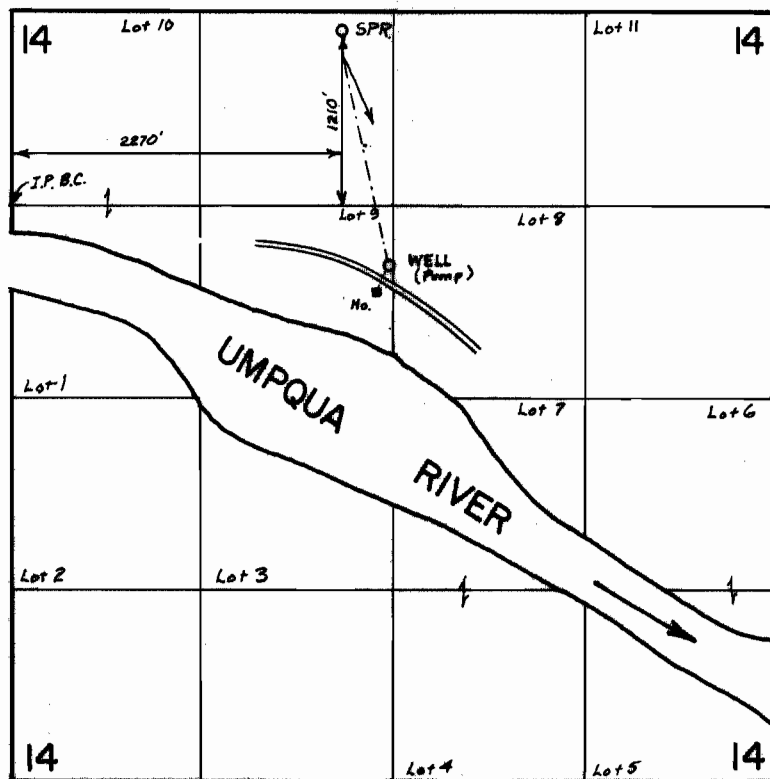

FINAL PROOF SURVEY UNDER

Application No. 43644 Permit No. 32626
IN NAME OF

MERLIN J. ROGERS

Surveyed APR 3 1973, by L. E. GOULD