


T.23S. R.4W. W.M.

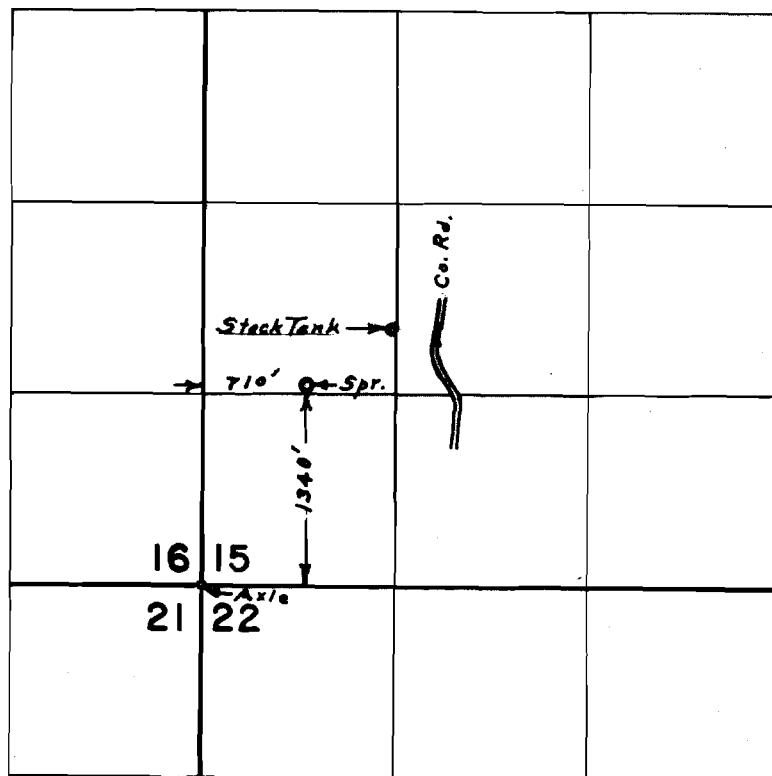

FINAL PROOF SURVEY
UNDER

Application No. 45486 Permit No. 33942
IN NAME OF

PERCY A. LANGDON

Surveyed April 6, 1973, by L. E. Gould