


T.27S., R.3W., W.M.

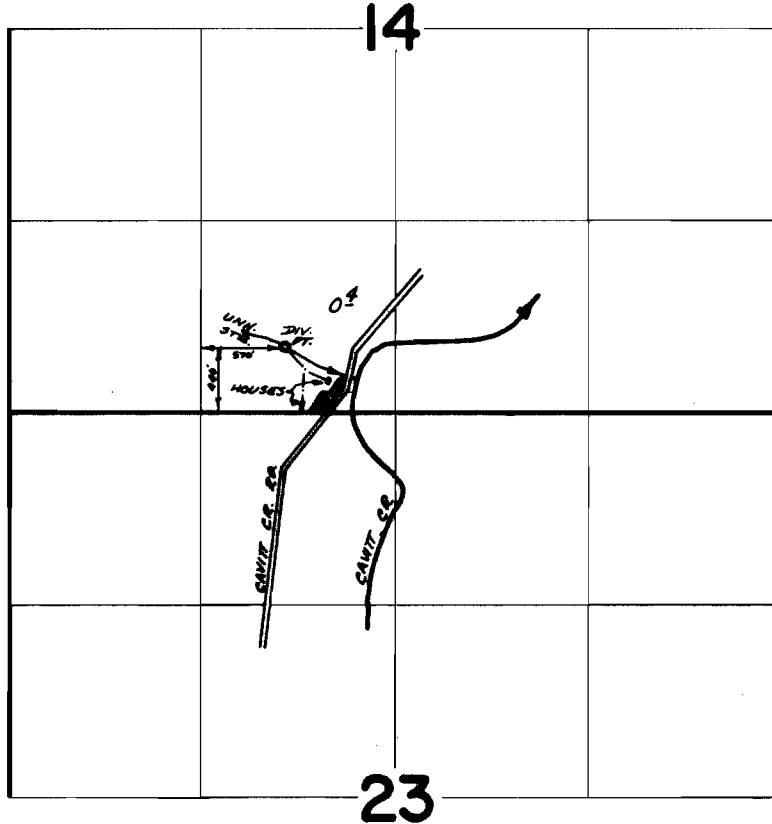

FINAL PROOF SURVEY
UNDER

Application No. 45758 Permit No. 34156
IN NAME OF

AUGUST T., JR. & LEAH A. CARLSON

Surveyed Sept. 12 1973, by D. Noeby