


T.30 S.R.3W.W.M.

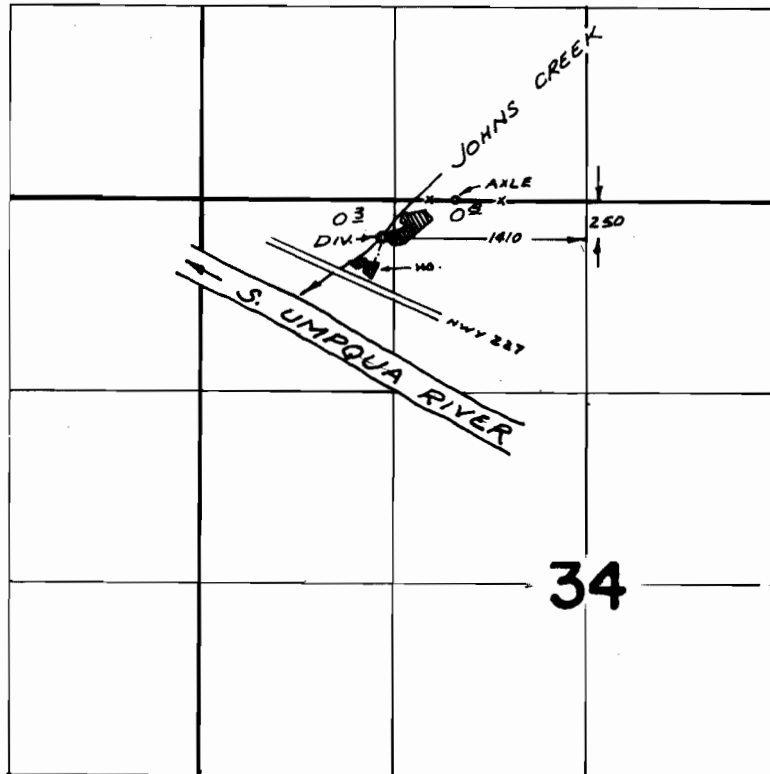

FINAL PROOF SURVEY
UNDER

Application No. 46142 Permit No. 34473
IN NAME OF

RICHARD E. & PATRICIA M. HARLOW

Surveyed JUNE 12, 1973, by R. MUCKEN