


T.27S.R.3W.W.M.

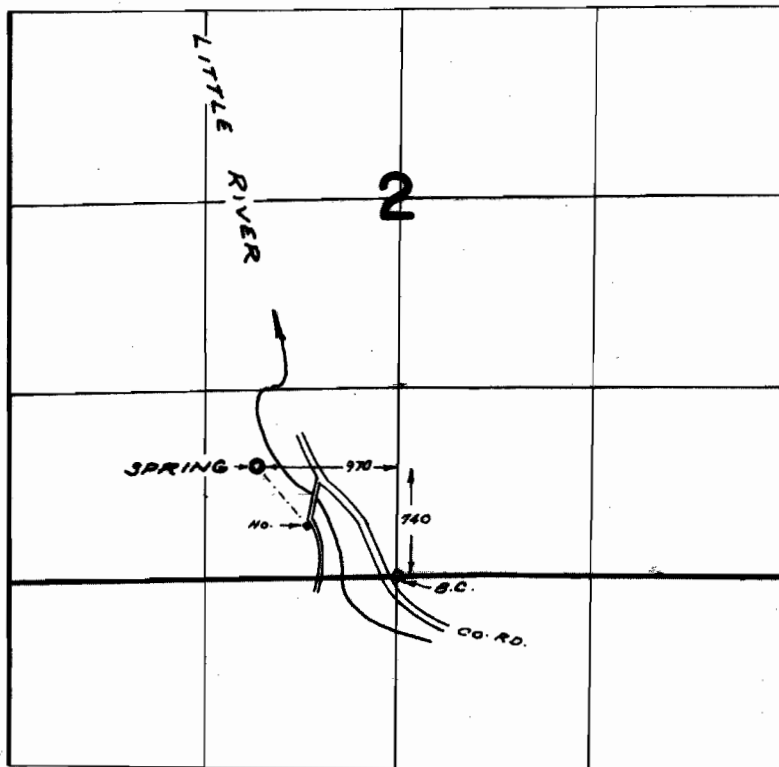

FINAL PROOF SURVEY
UNDER

Application No. 46916 Permit No. 35099
IN NAME OF

Gary L. Evans

Surveyed MAY 5, 1972, by R. MUCKEN