


DRAFTED WRONG

SEE A-50623

1. 25 S.R. 7W. W.M.

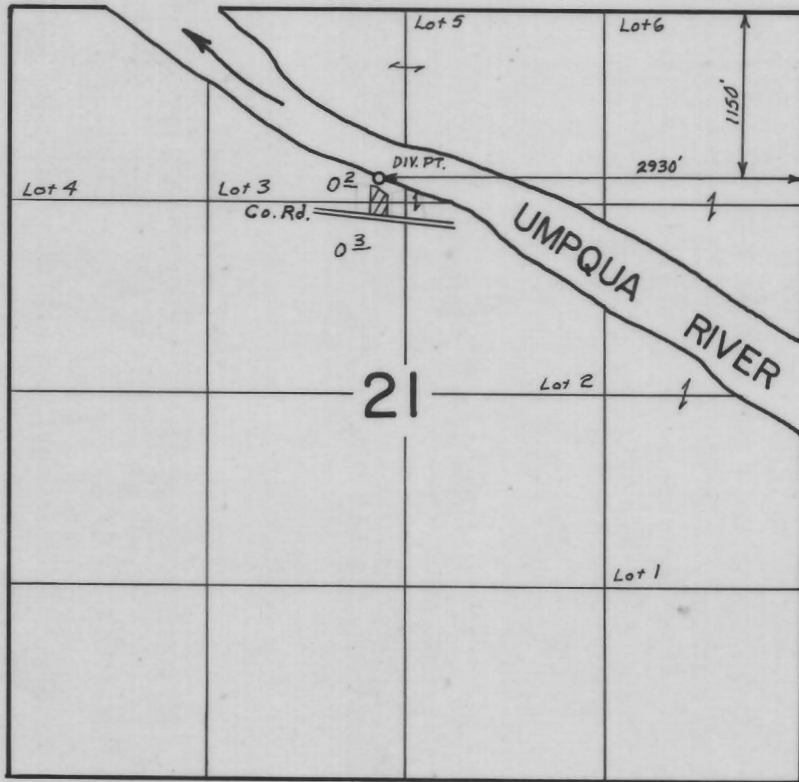


**FINAL PROOF SURVEY**  
UNDER

Application No. 47056 Permit No. 35193  
IN NAME OF

WALTER H. & SANDRA L. SPEER

Surveyed APR. 4, 1973, by L.E. GOULD

# T.25S.R.7W.W.M.

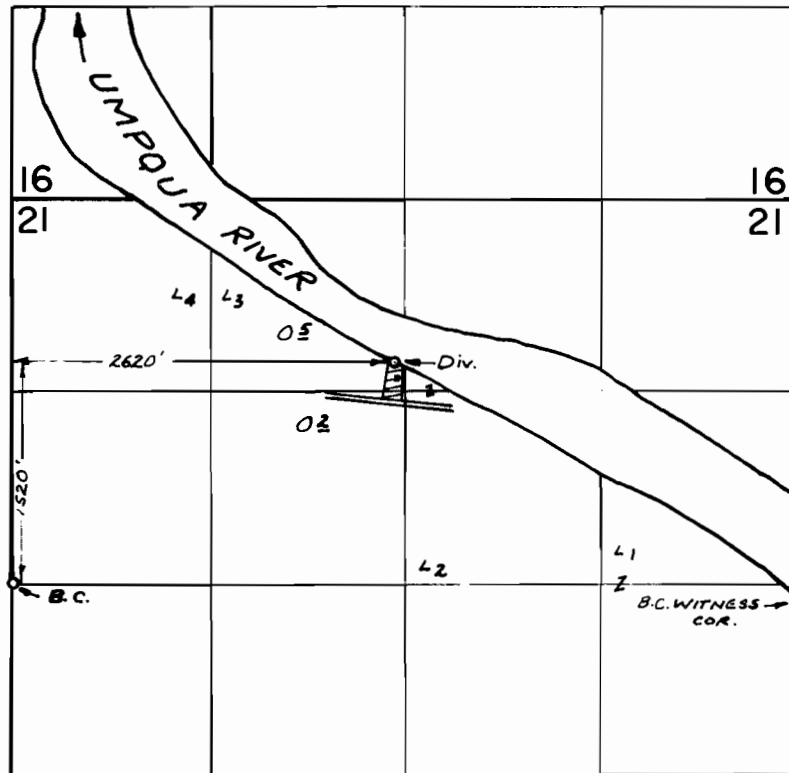

## FINAL PROOF SURVEY UNDER

Application No. 50623 Permit No. 38254  
IN NAME OF

CLAYTON K. & MARGUERITE R. HAYES

Surveyed MAY 27, 1976, by R. MUCKEN.