


T.29 S.R.1W.W.M.

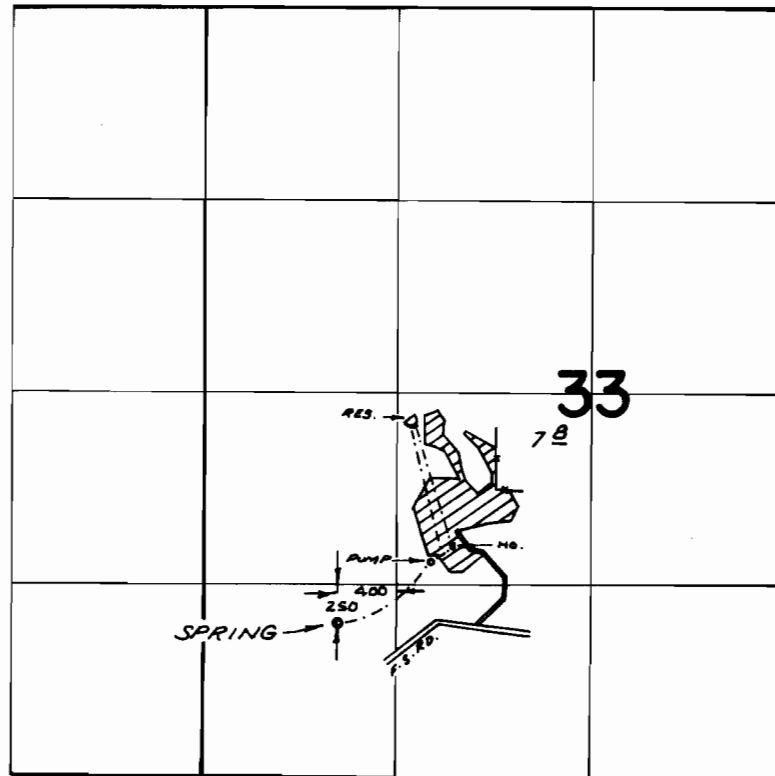

FINAL PROOF SURVEY
UNDER

Application No. 47337 Permit No. 35461
IN NAME OF

WANDA E. FREEBORN

Surveyed JUNE 13 1973, by R. MCKEN