


T.27S., R.6W., W.M.

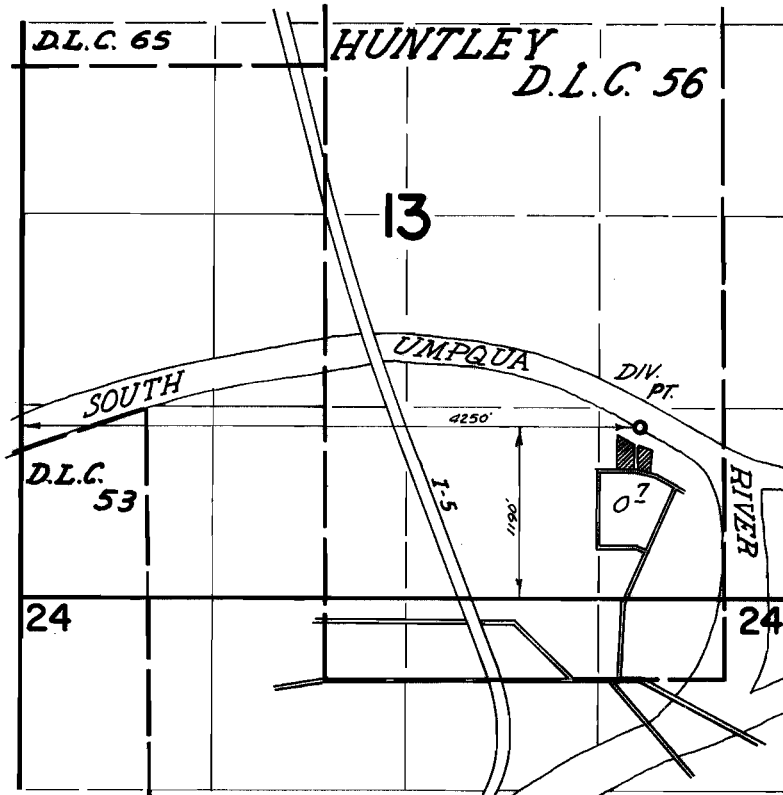

FINAL PROOF SURVEY
UNDER

Application No. 48109 Permit No. 36127
IN NAME OF

NOBLE B. GOETTEL

Surveyed Sept 11 1993, by D. NORBY