


T.30 S.R.5 W.W.M.

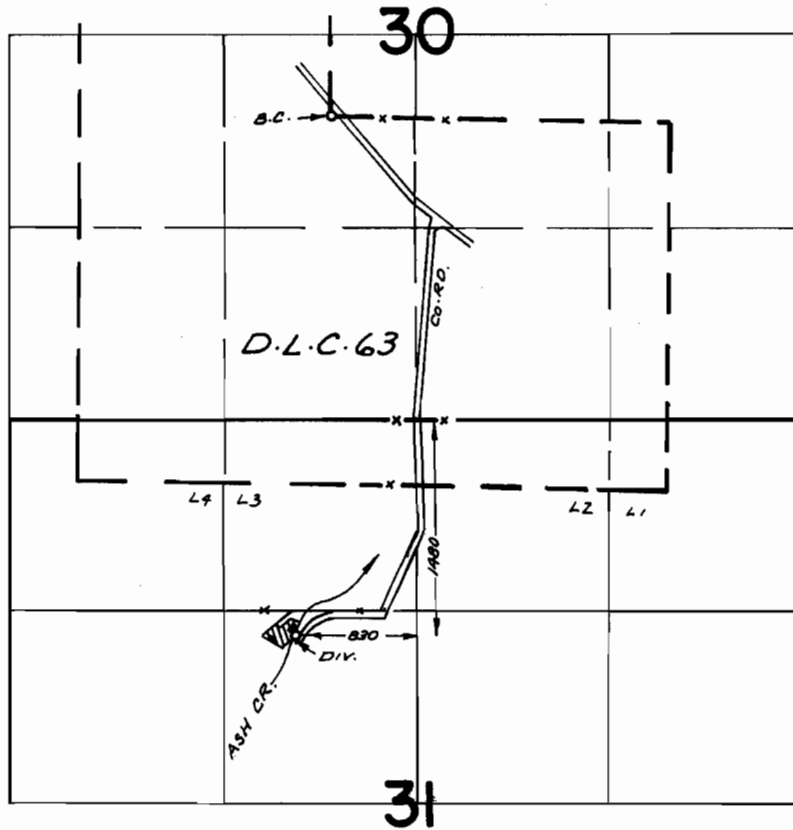

FINAL PROOF SURVEY UNDER

Application No. 48113 Permit No. 36130
IN NAME OF

PHIL G. FOGUS

Surveyed JUNE 14, 1973, by R. MUCKEN