


# T.30S.R.4W.W.M.

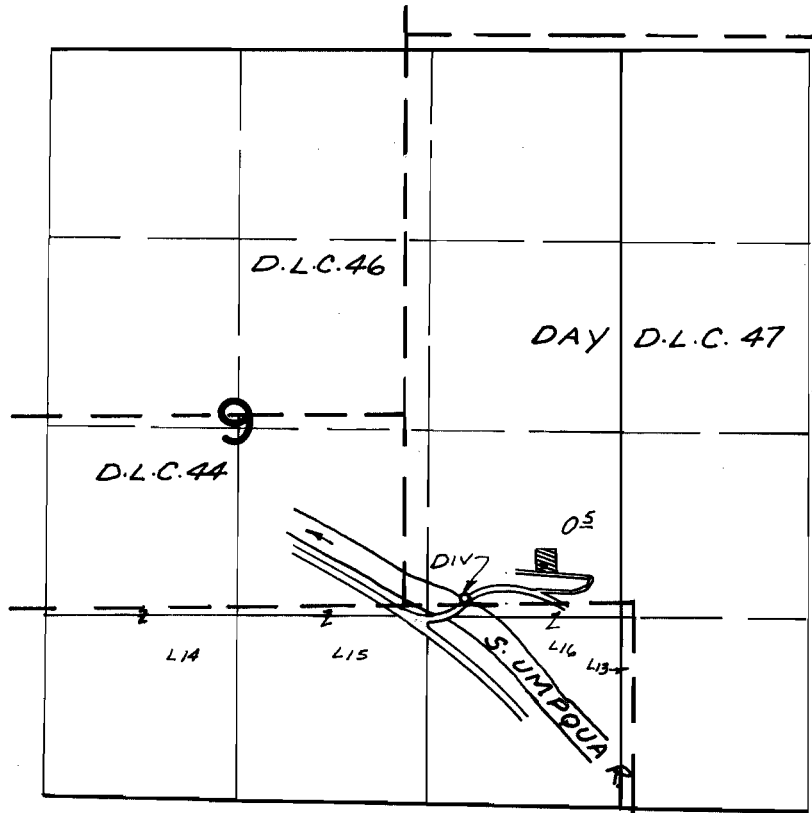

DIV. PT. LOC: 20' N & 160' W. FROM INTERIOR "L" COR. D.L.C. 47

## FINAL PROOF SURVEY UNDER

Application No. 48161 Permit No. 36181  
IN NAME OF

ROBERT MARTIN

Surveyed JUNE 11, 1973, by R. MUCKEN