


T.25S., R.4W., W.M.

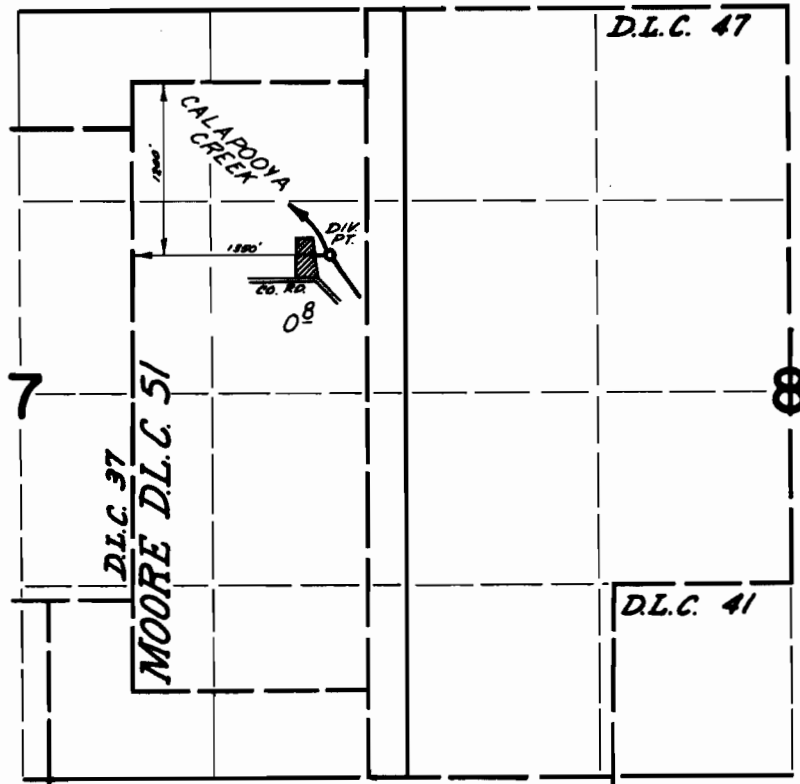

FINAL PROOF SURVEY
UNDER

Application No. 48852 Permit No. 36607
IN NAME OF

ROBERT C. BUERMANN

Surveyed Sept. 14 1973, by D. Noeby