


T.25S., R.6W., W.M.

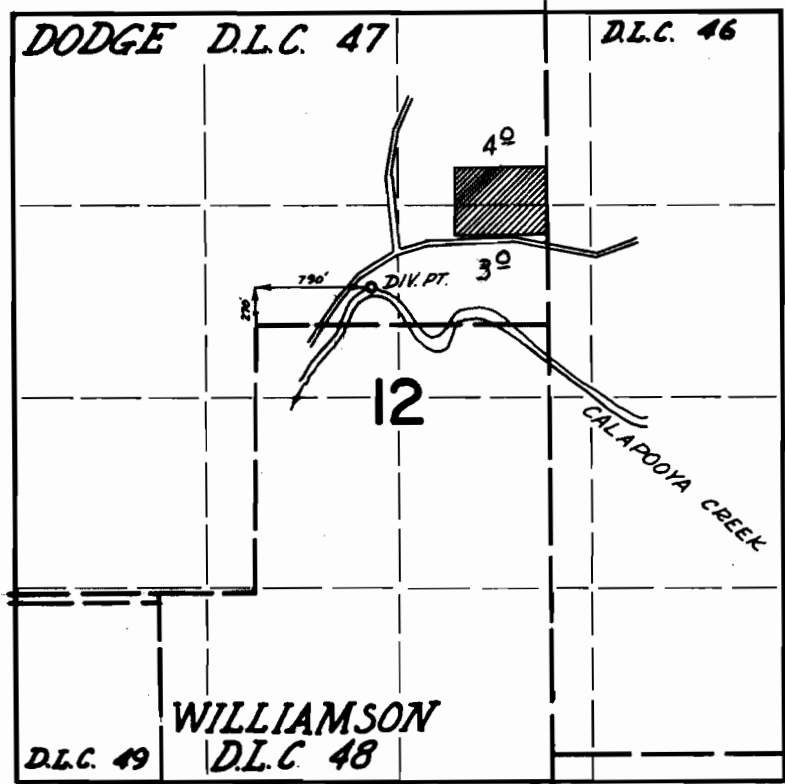

FINAL PROOF SURVEY
UNDER

Application No. 48865 Permit No. 36613
IN NAME OF

GEORGE ALFRED TRUMBO

Surveyed Sept. 10 1973, by D. NORBY