


T.25S., R.7W., W.M.

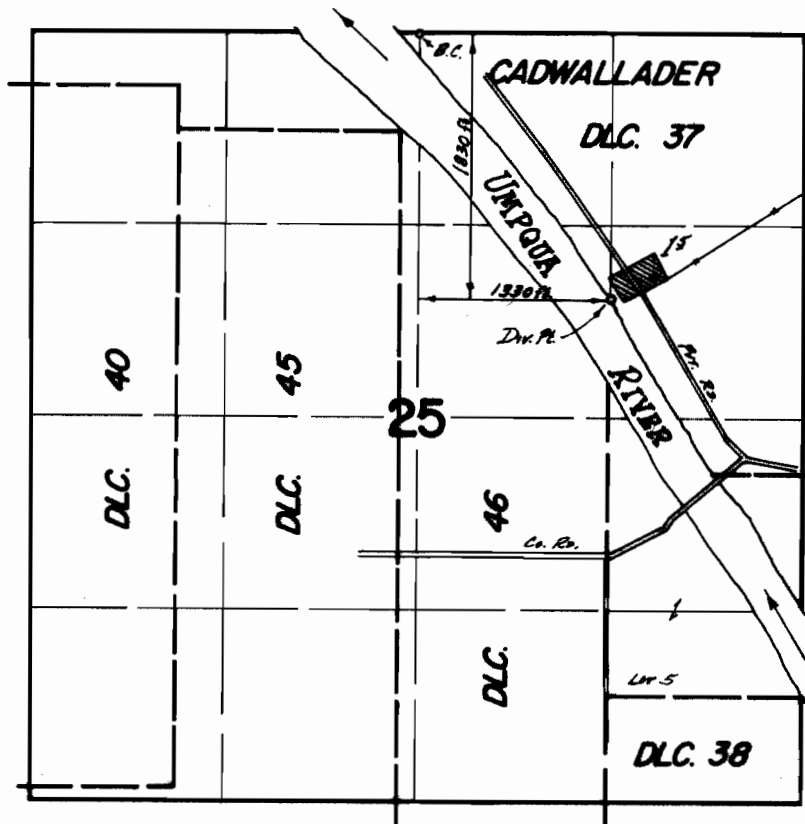

**FINAL PROOF SURVEY**  
UNDER

Application No. 47697 Permit No. 35731  
IN NAME OF

PAUL E. VERMILLION

Surveyed SEPT. 10. 19. 73. by D. NORBY