


T.2N., R.8E., W.M.

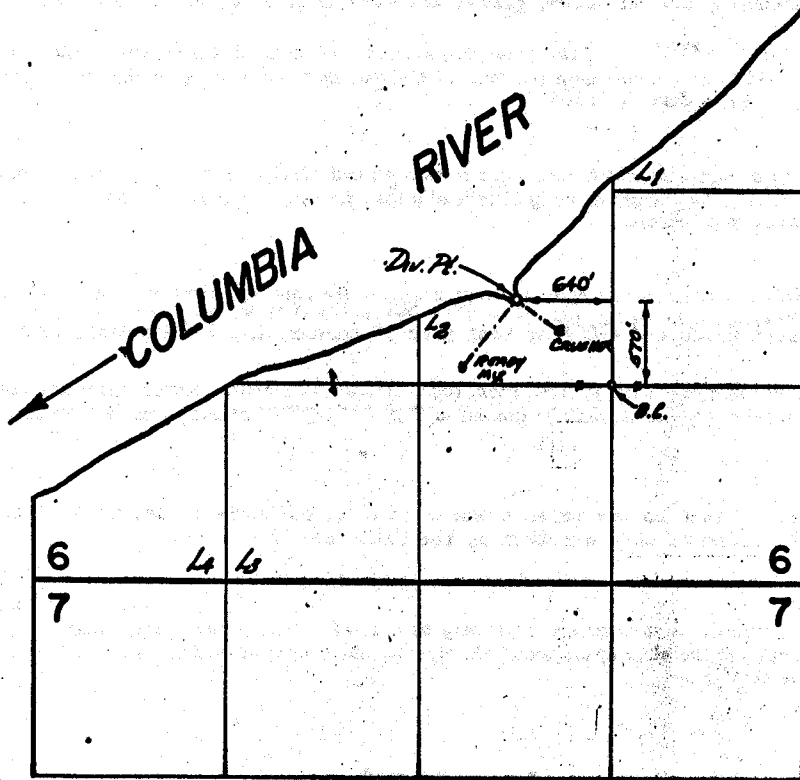

FINAL PROOF SURVEY
UNDER

Application No. 39937 Permit No. 29725
IN NAME OF

John J. Nelson, dba Hood River Sand, Gravel, & Ready Mix

Surveyed Aug 27 1973, by D. Nardy