


T.2N., R.10E., W.M.

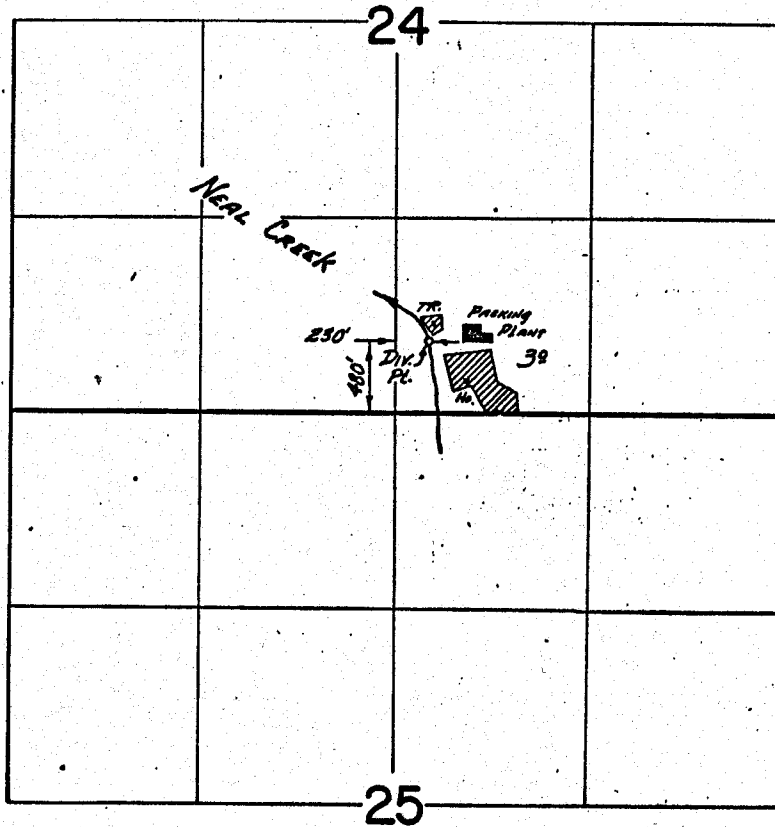

FINAL PROOF SURVEY
UNDER

Application No. 40780 Permit No. 30389
IN NAME OF

EARL A. MOORE, dba. MOORE ORCHARDS, INC.

Surveyed Aug 28 1973, by D NORBY