


T. 1N., R. 10E., W.M.

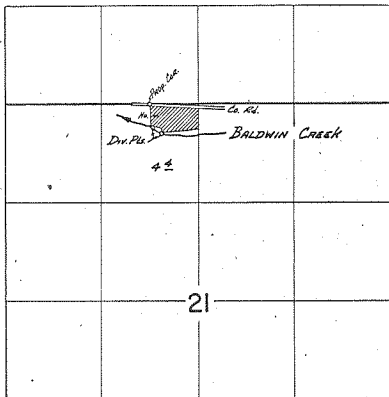

Div Pts. loc. #1-390'S. of 510'W.; #2-330'S. of 630'W.; both from
the N 1/4 cor. Sec. 21.

FINAL PROOF SURVEY
UNDER

Application No. 48331 Permit No. 36294
IN NAME OF

JOE DEAN GILL

Surveyed Aug 29 1973, by D. Nacey