


T.2N., R.10E., W.M.

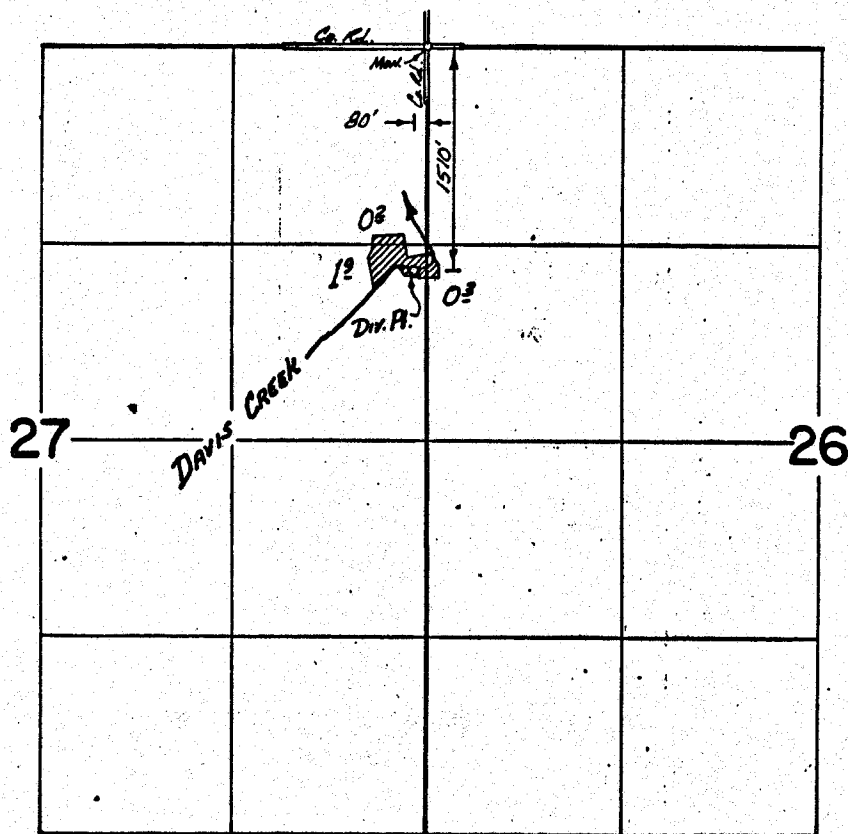

**FINAL PROOF SURVEY**  
UNDER

Application No. 49706 Permit No. 36533  
IN NAME OF

ELMER W. MURRAY

Surveyed Aug. 28, 1973, by D. NORBY