


T.3N.,R.10E.,W.M.

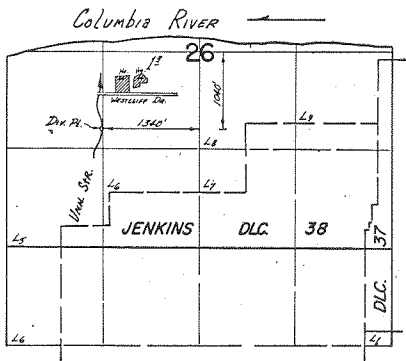

FINAL PROOF SURVEY  
UNDER

Application No. 48818 Permit No. 36593  
IN NAME OF

FORREST L. & ELLEN B. MOE - PAUL M. & SUSAN J. HAMADA

Surveyed Aug. 30, 1972, by D. Noyes