


T.38S., R.4W., W.M.

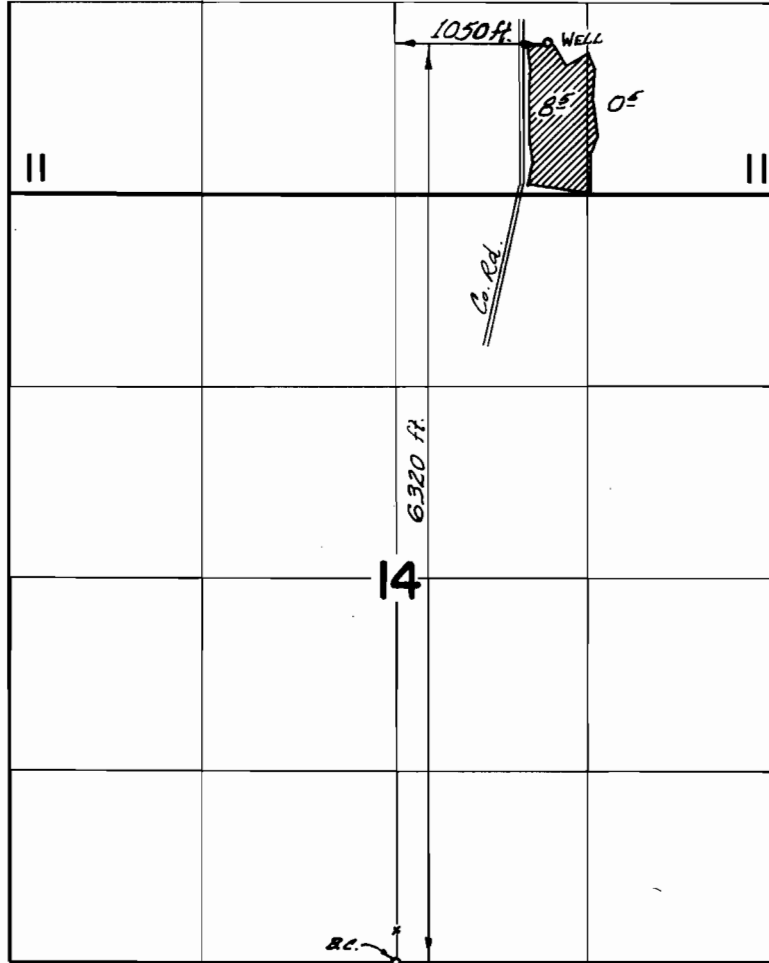

FINAL PROOF SURVEY
UNDER

Application No. G-4693 Permit No. G-4412
IN NAME OF

WILLIAM PITTOCK

Surveyed Oct 11 1973, by D. NORBY