


T. 36 S. R. 4 W. W.M.

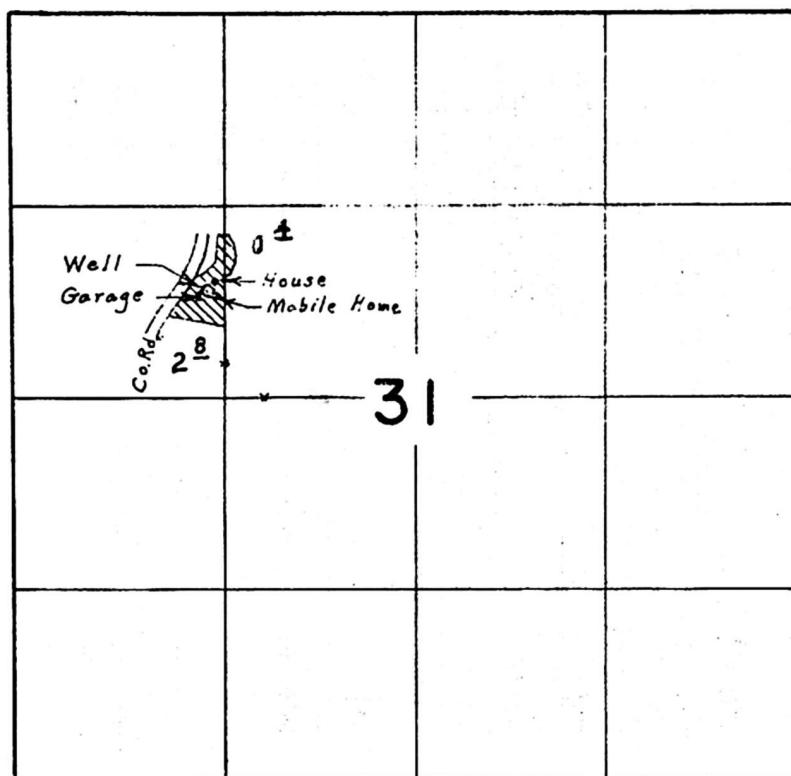

Well located 730' N. & 120' W. from S. E. Cor. S.W. $\frac{1}{4}$ N.W. $\frac{1}{4}$ Sec. 31

**FINAL PROOF SURVEY
UNDER**

Application No. G-4979 Permit No. G-4645

IN NAME OF

DAVID & GERTRUDE REED

Surveyed Oct. 3, 1973, by L. E. Gould