


T. 36 S.R.3 W. W.M.

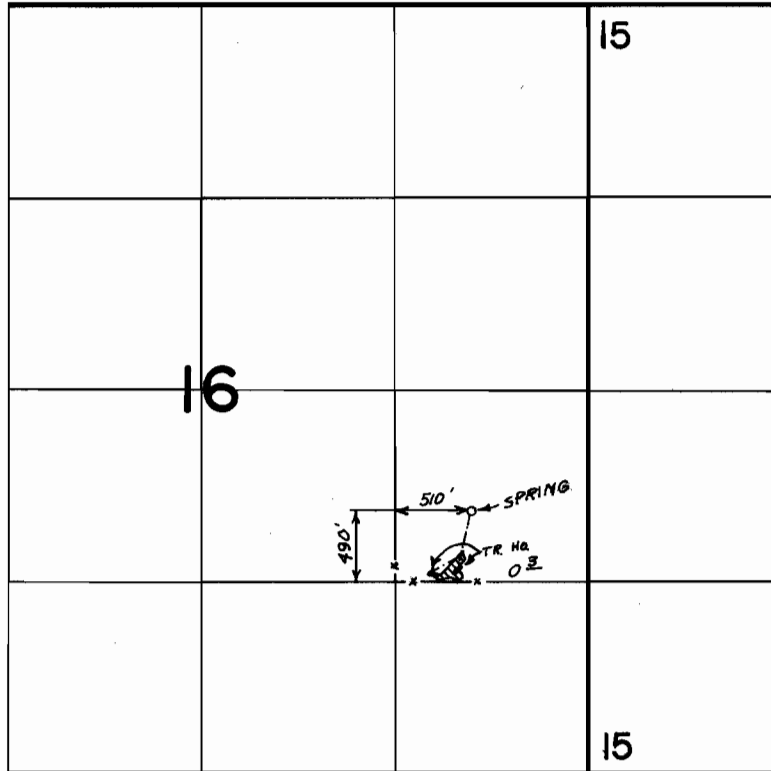

FINAL PROOF SURVEY UNDER

Application No. 41586 Permit No. 31019
IN NAME OF

CLIFFORD HUFFMAN &/OR ARLO BOUSLAUGH

Surveyed OCT 10 1973, by R.G.MUCKEN