


T.35S. R.3W. W.M.

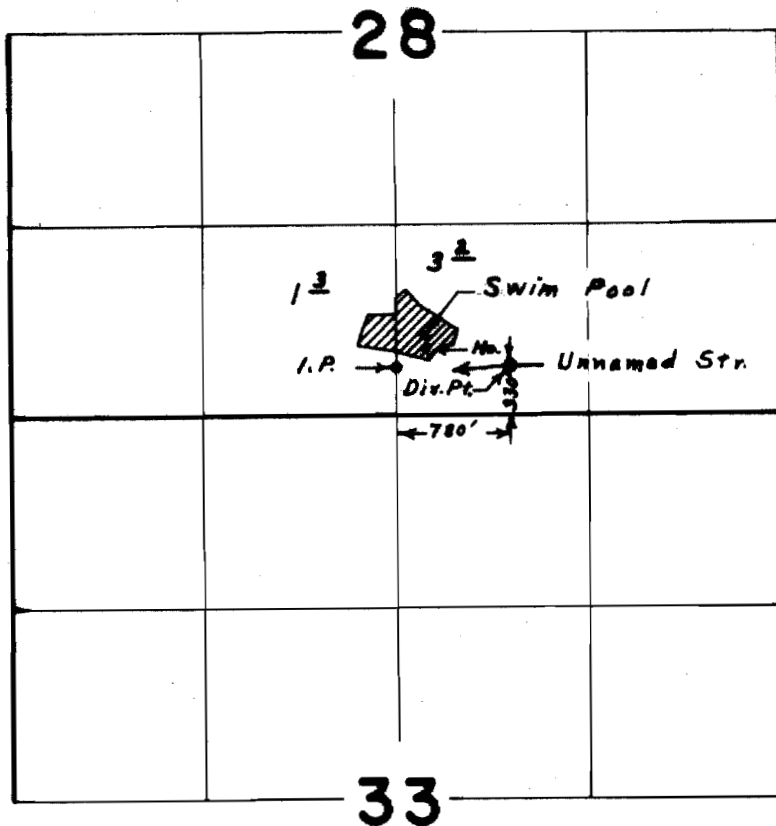

**FINAL PROOF SURVEY
UNDER**

Application No. 42104 Permit No. 31533

IN NAME OF
WILLIAM E. COLLINS & OR
MARION R. CLANCY

Surveyed Oct. 2, 1973, by L. E. Gould