


T.36S. R.3W. W.M.

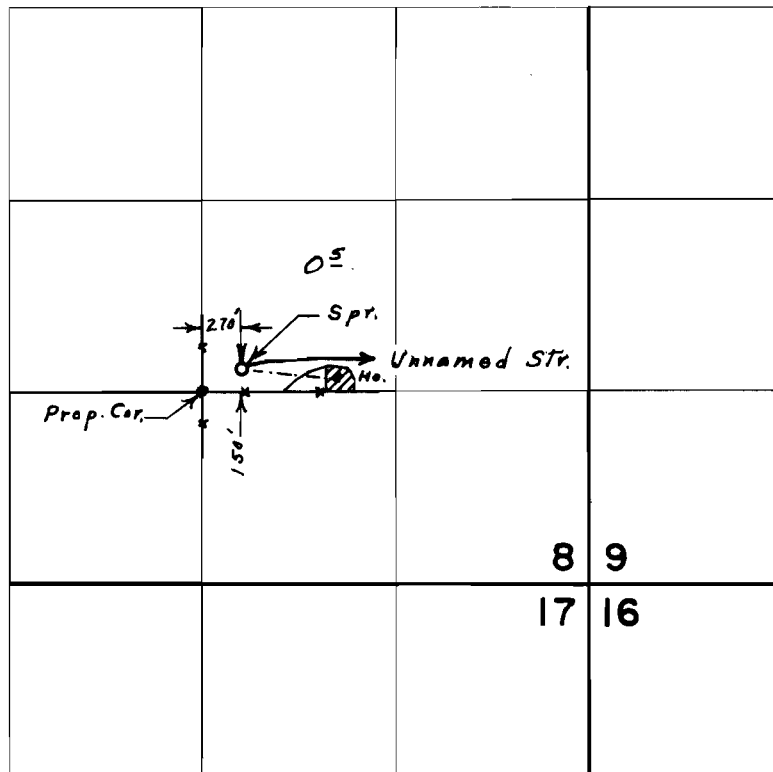

FINAL PROOF SURVEY
UNDER

Application No. 42678 Permit No. 31894
IN NAME OF
C. E. FOOTE

Surveyed Sept. 29, 1973, by L. E. Gould