


T.38S.,R.4W.,W.M.

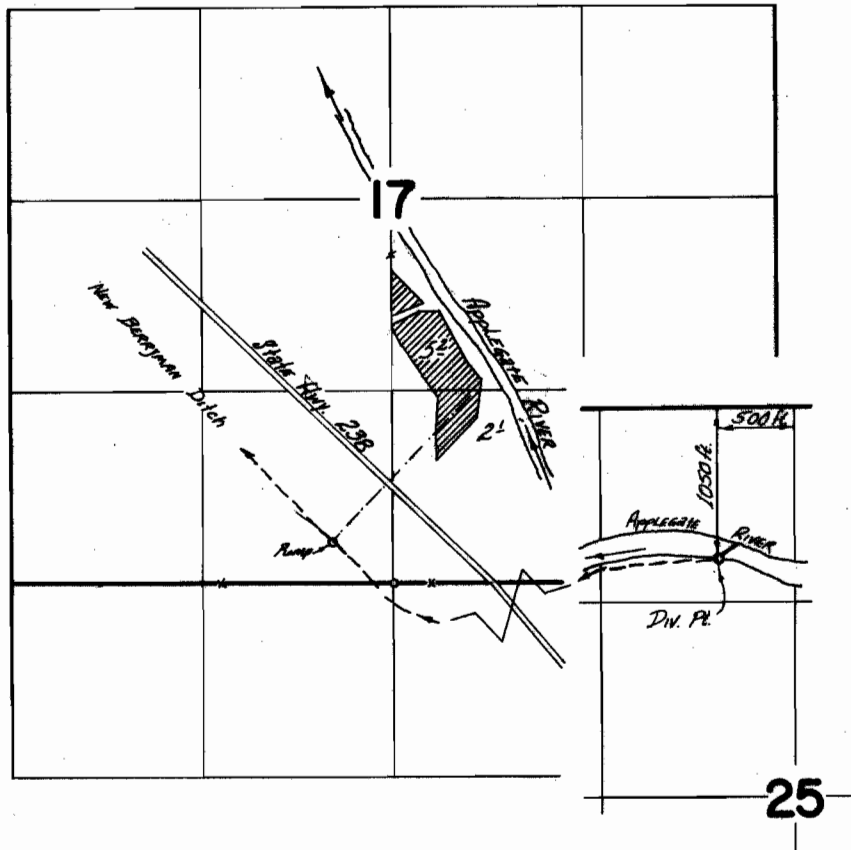

FINAL PROOF SURVEY
UNDER

Application No. 45679 Permit No. 34081
IN NAME OF

ELDEN C. SNYDER

Surveyed Oct. 10 1973, by D. Norby