


T.38S.,R.4W.,W.M.

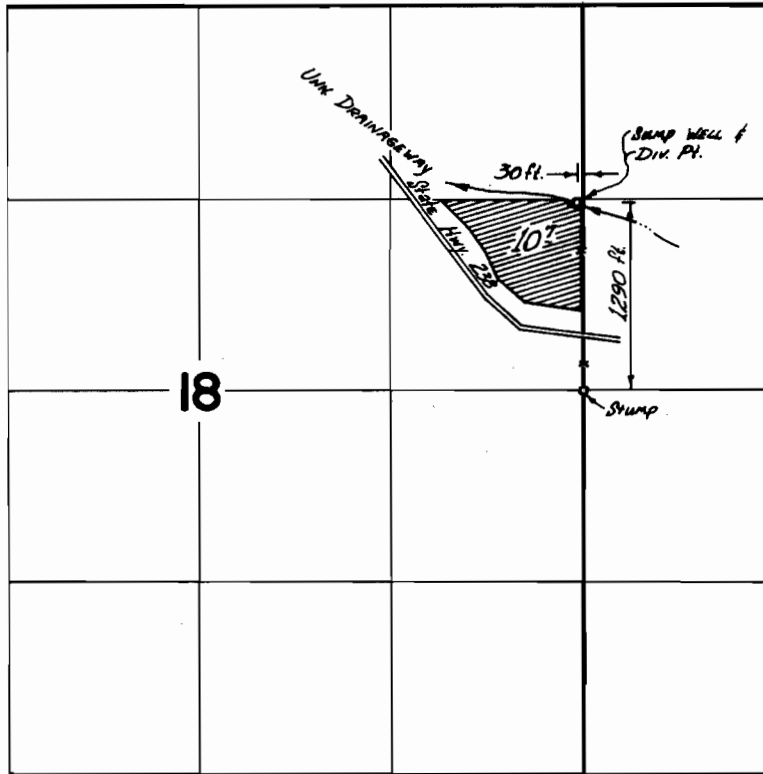

FINAL PROOF SURVEY
UNDER

Application No. 46058 G-4295 Permit No. 34395 G-4043
IN NAME OF

ASHTON FOERST

Surveyed Oct 9 1973, by D. NORBY