


T. 36 S.R. 4W.W.M.

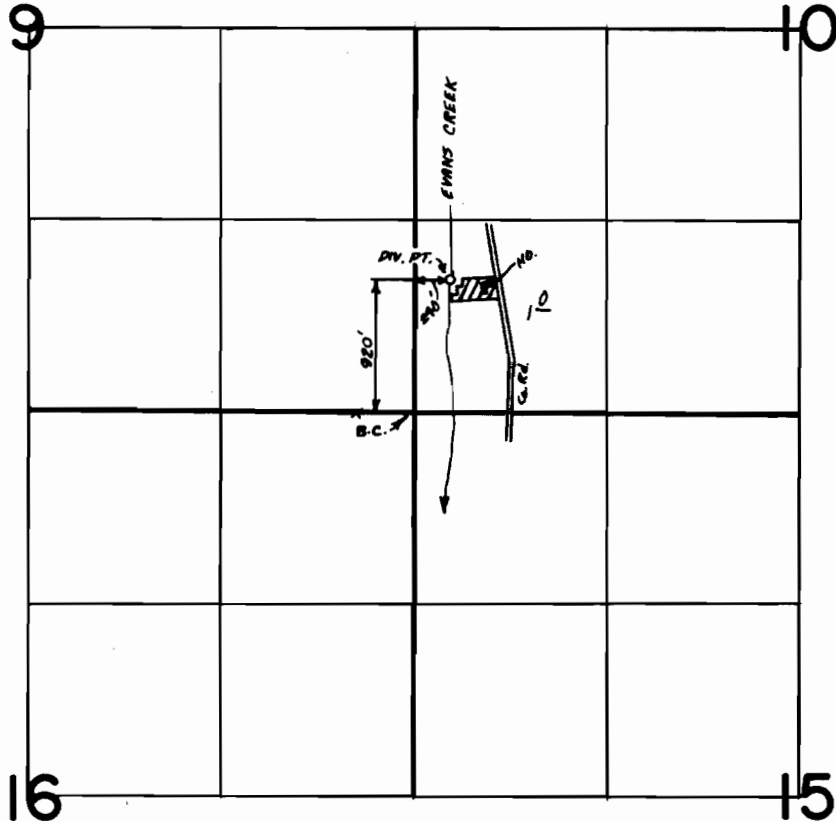

**FINAL PROOF SURVEY**  
UNDER

Application No. 46078 Permit No. 34431  
IN NAME OF

WILLIAM C. LOVELL

Surveyed OCT 12 1973, by R.G. MUCKEN