


T. 37 S. R. 4 W. W.M.

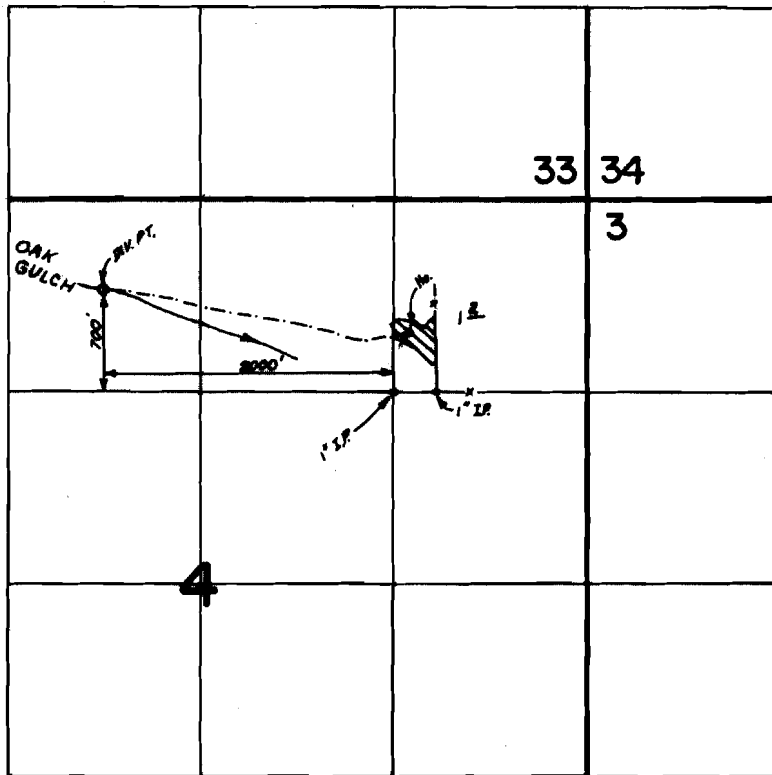

FINAL PROOF SURVEY UNDER

Application No. 46231 Permit No. 34541
IN NAME OF

CARL J. & MARGARET V. STRUBY

Surveyed OCT. 15 1973, by R.G. MUCKEN