


T. 36 S. R. 4 W. W.M.

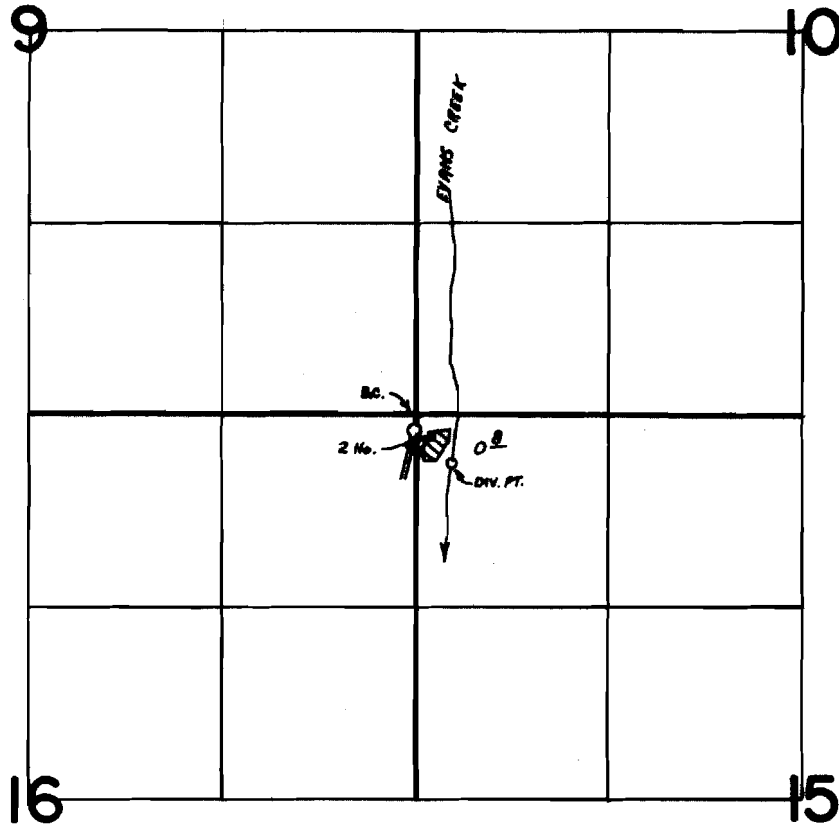

DIV. PT. 330' S & 250' E FROM NW COR. SEC. 15

FINAL PROOF SURVEY
UNDER

Application No. 46320 Permit No. 34609
IN NAME OF

HAYDEN B. JONES

Surveyed OCT 12 1973, by R.G. MUCKEN