


T.38S.,R.4W.,W.M.

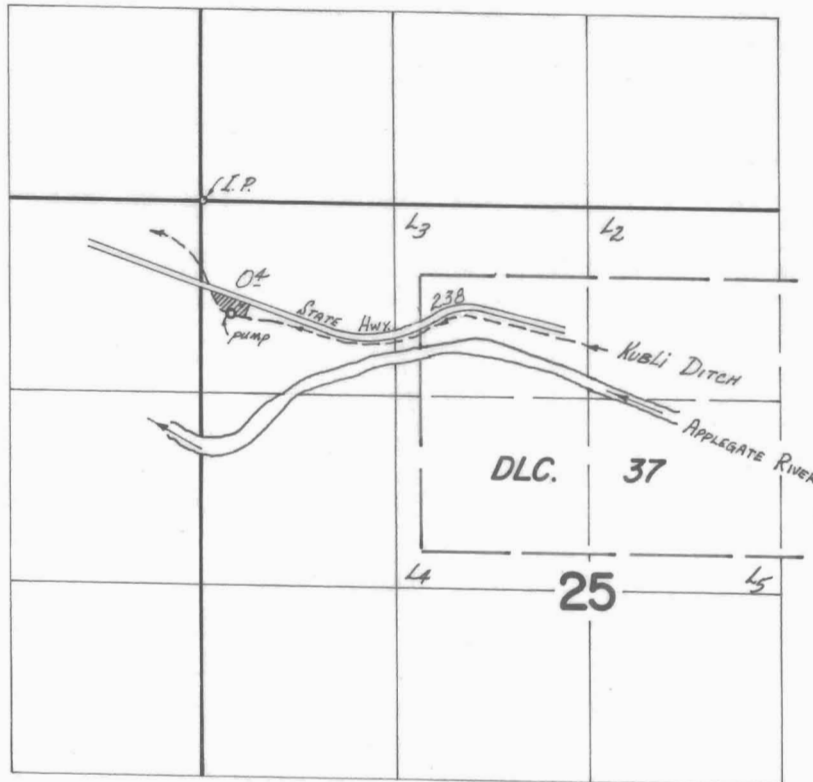

KUSLI DITCH DIV. PT. LOCATED IN SE 1/4 SW 1/4 AS PROJECTED WITHIN
LONG DLC. 39, Sec. 30, T.38 S., R.3 W., W.M.; 2510' S. & 3370' W.
FROM NE COR. LONG DLC. 39.

FINAL PROOF SURVEY
UNDER

Application No. 46715 Permit No. 34909
IN NAME OF

CLARENCE W. CLOUSER

Surveyed Oct. 15 19 73, by D. Norby