


# T.36S.R.3W.W.M.

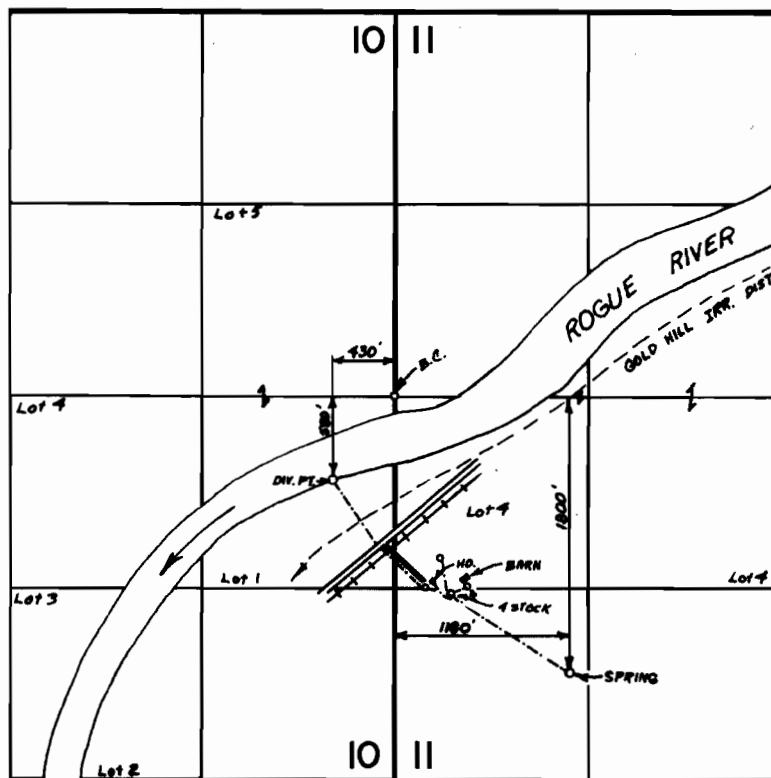

## FINAL PROOF SURVEY UNDER

Application No. 46788 Permit No. 34937  
IN NAME OF

HEBER V. & LORETTA F. HYMAS

Surveyed OCT. 9 1973, by R. G. MUCKEN