


T.36 S. R.4 W. W.M.

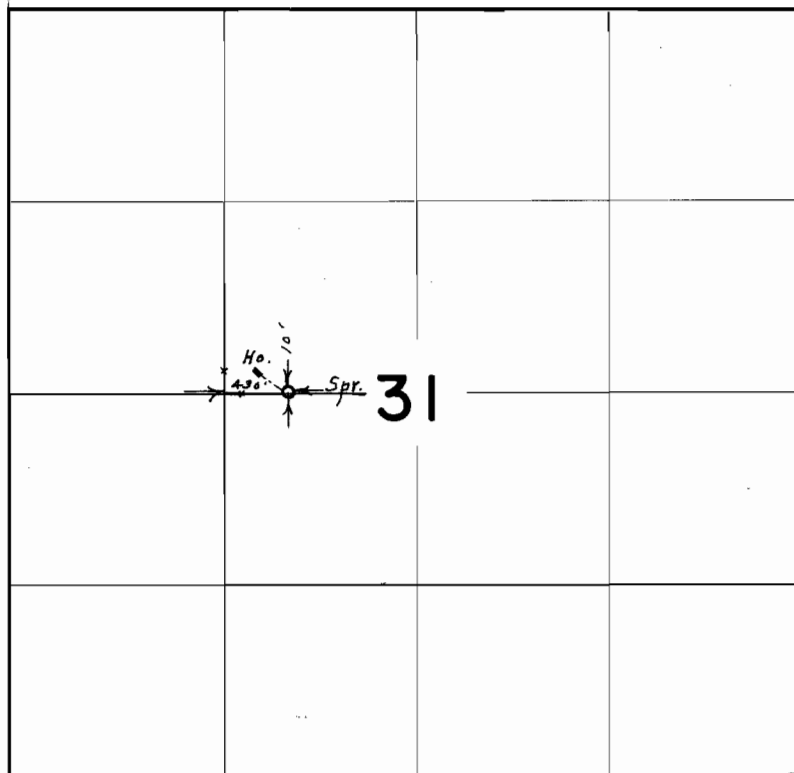

FINAL PROOF SURVEY
UNDER

Application No. 48271 Permit No. 35265
IN NAME OF

ROBERT E. HOWE

Surveyed Oct. 3, 1973, by L. E. Gould