


T.38S.,R.4W.,W.M.

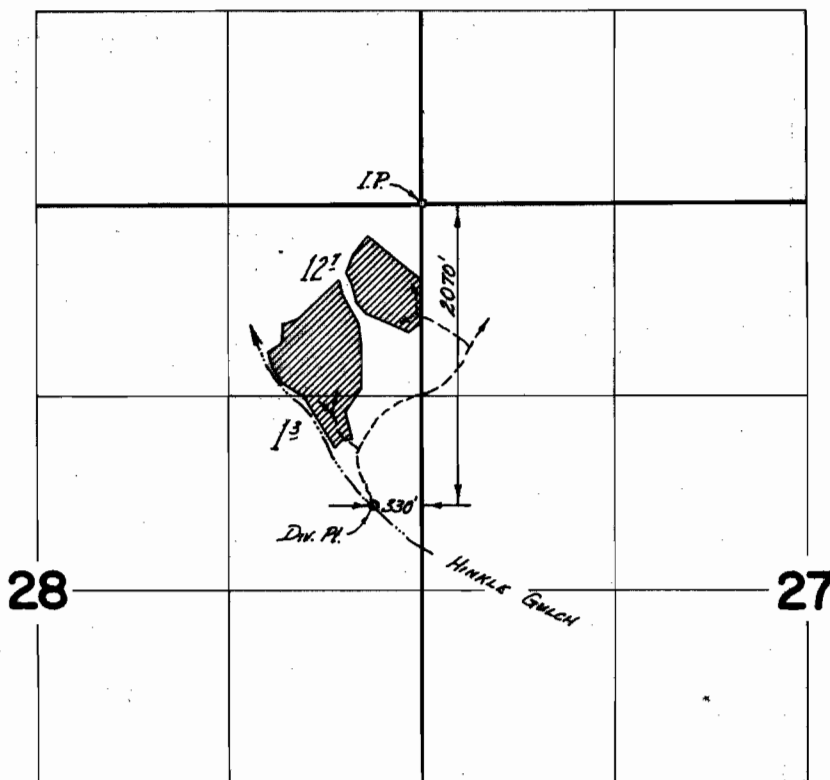

FINAL PROOF SURVEY
UNDER

Application No. 47613 Permit No. 35638
IN NAME OF

JOHN & MAXINE E. DeYOUNG

Surveyed Oct. 12, 1973, by D. Norey