


T.35 S.R.2W.W.M.

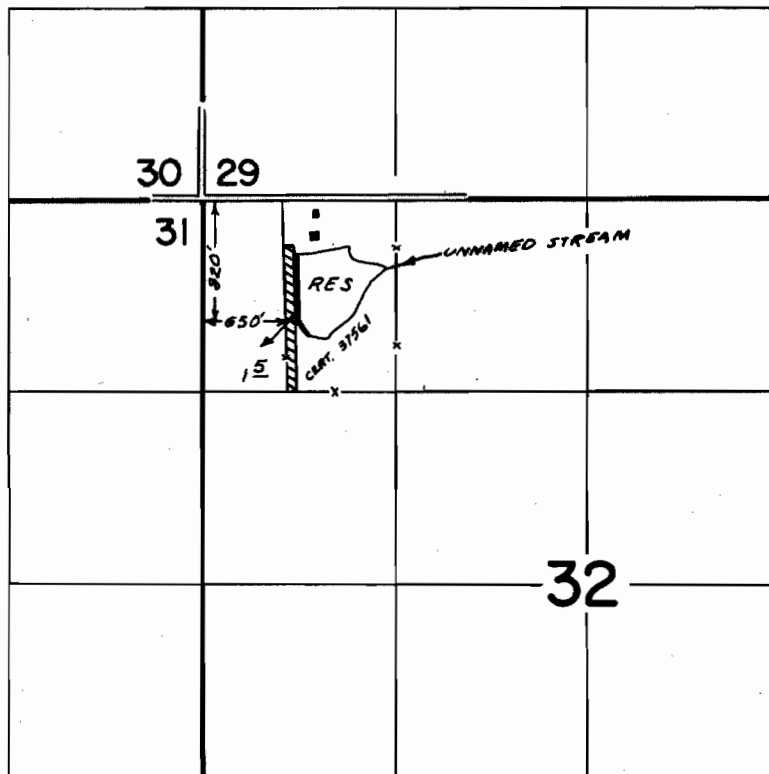

FINAL PROOF SURVEY
UNDER

Application No. 48103 Permit No. 36124
IN NAME OF

MRS. JUANITA F. BUSH

Surveyed OCT 16 1973, by R.G. MUCKEN