


T. 35S.R.2W. W.M.

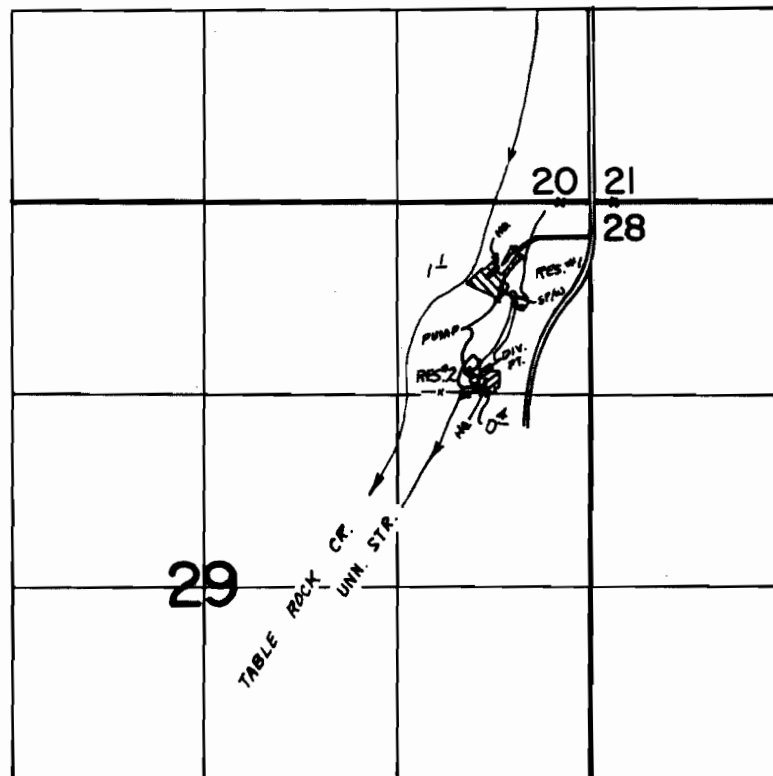

[Hatched Box] RES #1-DAM: 650' S & 540' W FROM NE COR. SEC. 29
 [Hatched Box] RES #2- OFF-CHANNEL: 1170' S & 770' W FROM NE COR. SEC. 29
 DAM: 1280' S & 880' W FROM NE COR SEC 29

FINAL PROOF SURVEY UNDER

R-42594 R-4857
 Application No. 42595 Permit No. 31945
 IN NAME OF

FRANK B. OR NADINE R. BAIN

Surveyed OCT 17 1973, by R.G. MUCKEN