


T.38S.,R.2W.,W.M.

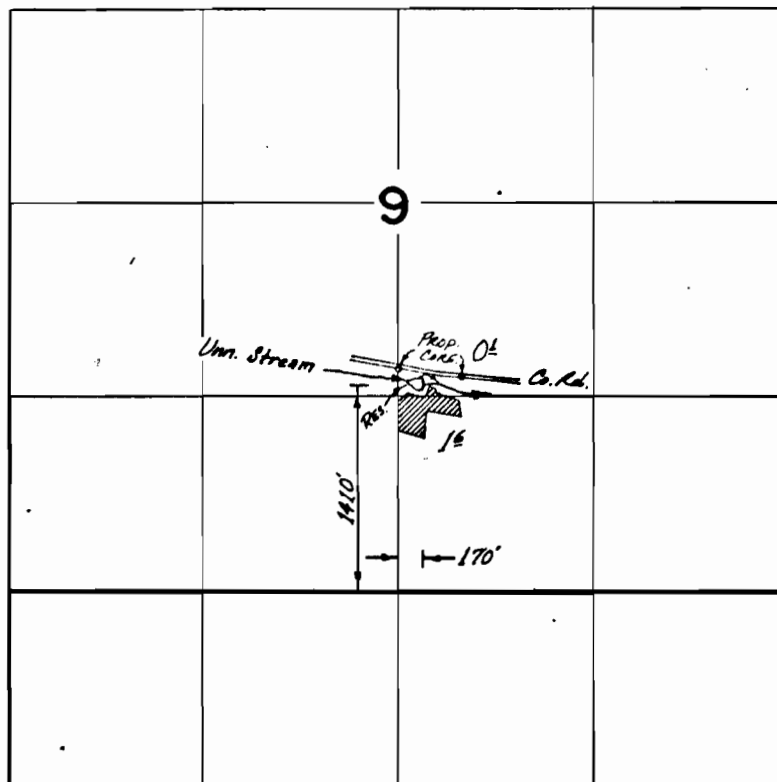

FINAL PROOF SURVEY
UNDER

R-46509 R-5545
Application No. 46510 Permit No. 34750
IN NAME OF

EMERSON T. ANDERSON

Surveyed Oct. 17 1973, by D. NORBY