


T.39S.,R.3W.,W.M.

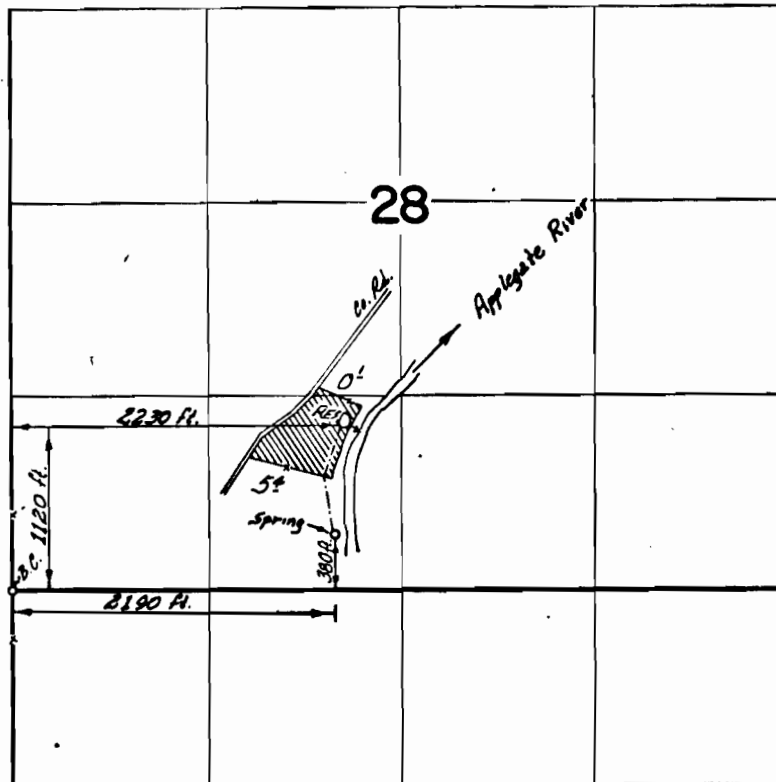

FINAL PROOF SURVEY
UNDER

R-46575 R-5563
Application No. 46576 Permit No. 34808
IN NAME OF

JAMES F. & GLENNA H. CORSON

Surveyed Oct. 16 1973, by D. Noeby