


T.38S,R2W,W.M.

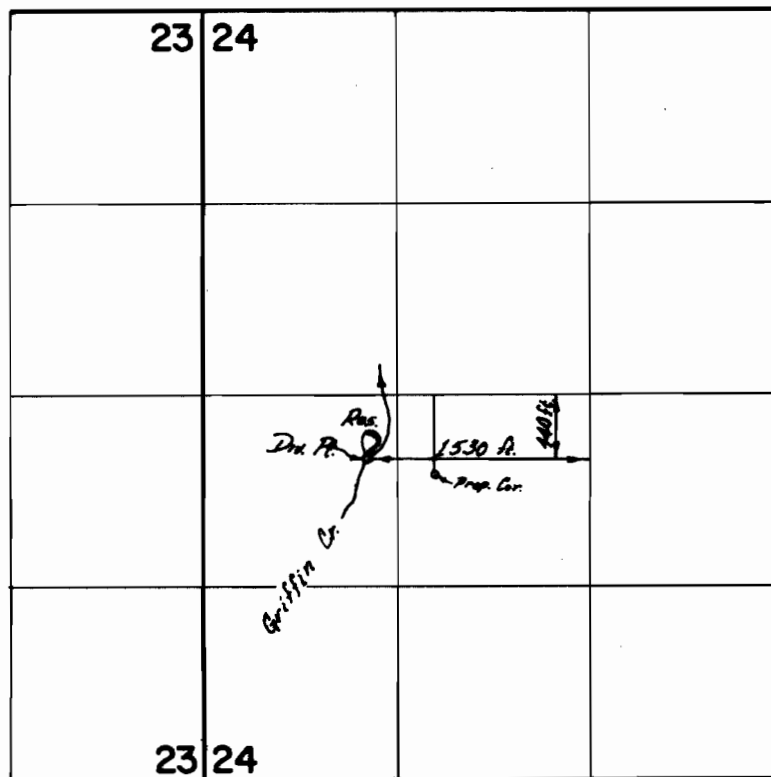

FINAL PROOF SURVEY
UNDER

Application No. R-47236 Permit No. R-5680
IN NAME OF

DON L. & VIDA M. HIRSCHY

Surveyed Oct. 18 1973, by D. Norby