


T.38S., R.9E., W.M.

Upper Klamath Lake wells

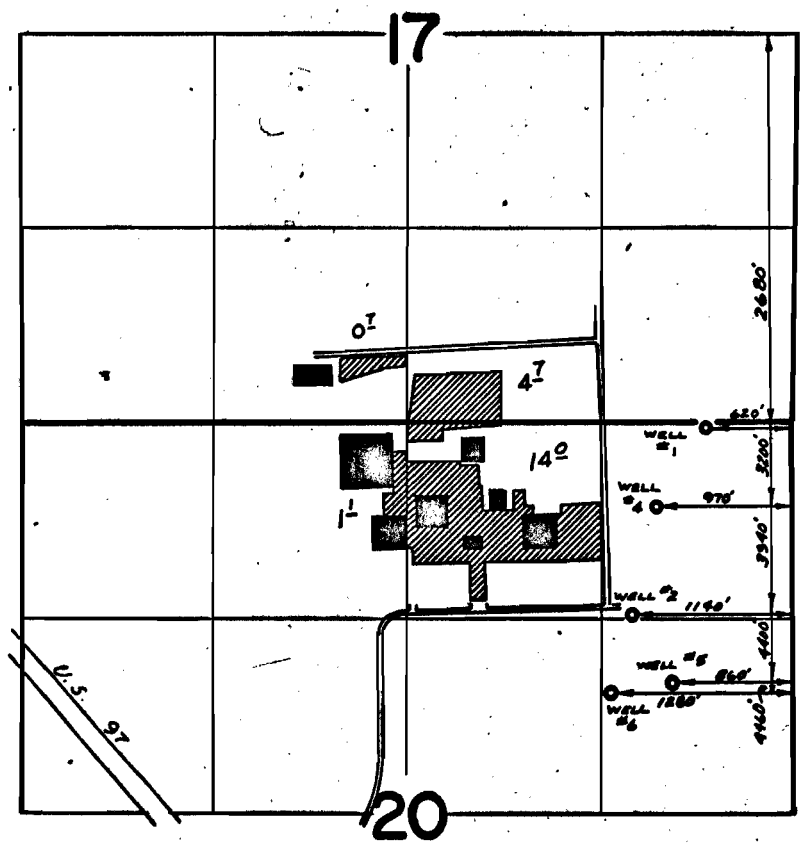

FINAL PROOF SURVEY UNDER

Application No. *G-2511* Permit No. *G-2387*
IN NAME OF

OREGON TECHNICAL INSTITUTE

Surveyed *Oct. 9* 19*22*, by *D. Nerby*