


T.15S., R.5 W., W.M.

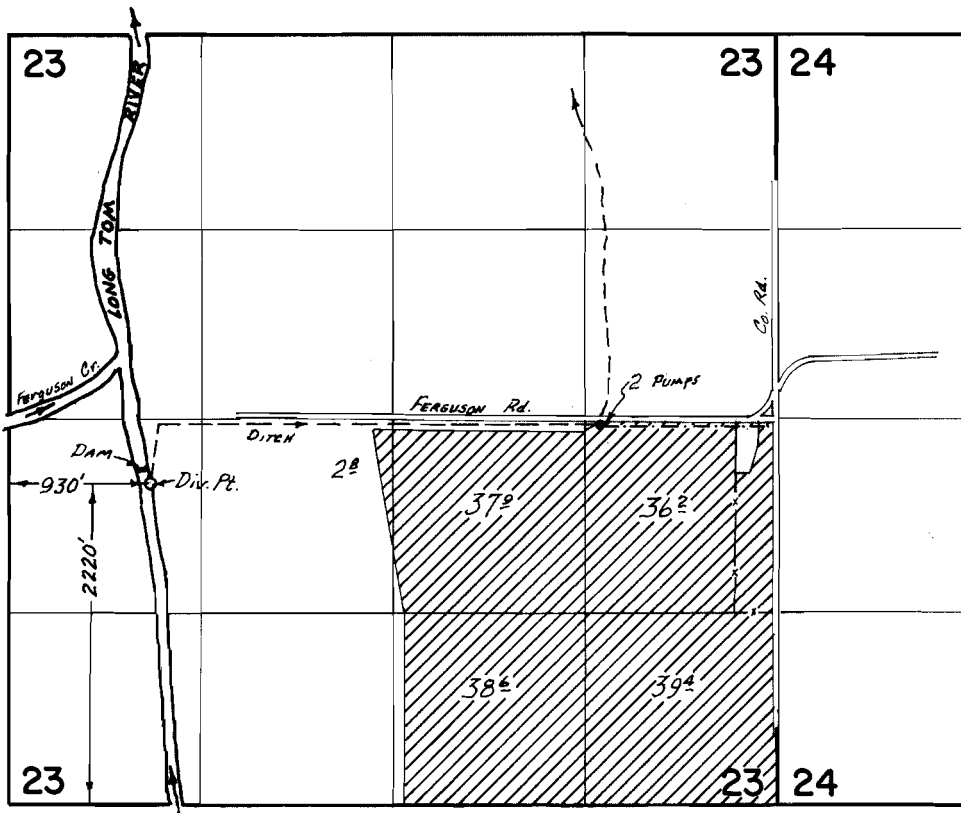

FINAL PROOF SURVEY
UNDER

Application No. 44579 Permit No. 33369
IN NAME OF

KEITH L. KINNEY & CARL J. & ANNA E. CROSIAR

Surveyed 26 Sept. 1972, by D. NORBY