


T.15S., R.5 W., W.M.

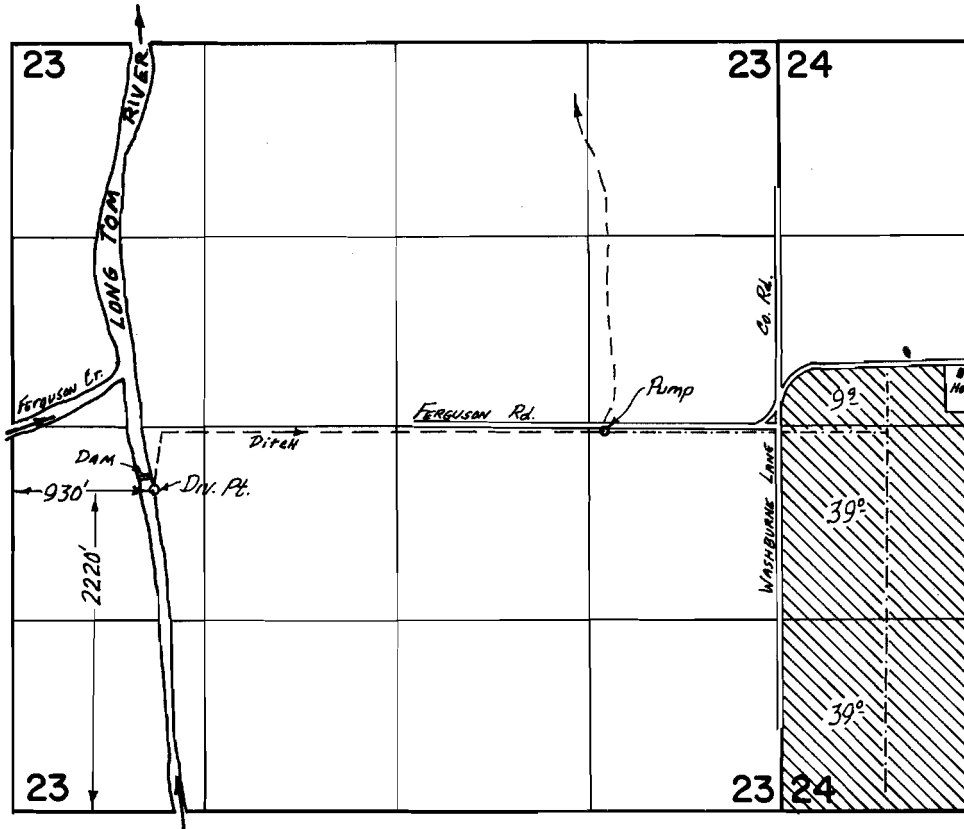

FINAL PROOF SURVEY
UNDER

Application No. 44581 Permit No. 33418
IN NAME OF

CARL J. CROSIAR

Surveyed 25 Sept. 19 72 by D. NORBY