


T.3N.R.10W. W.M.

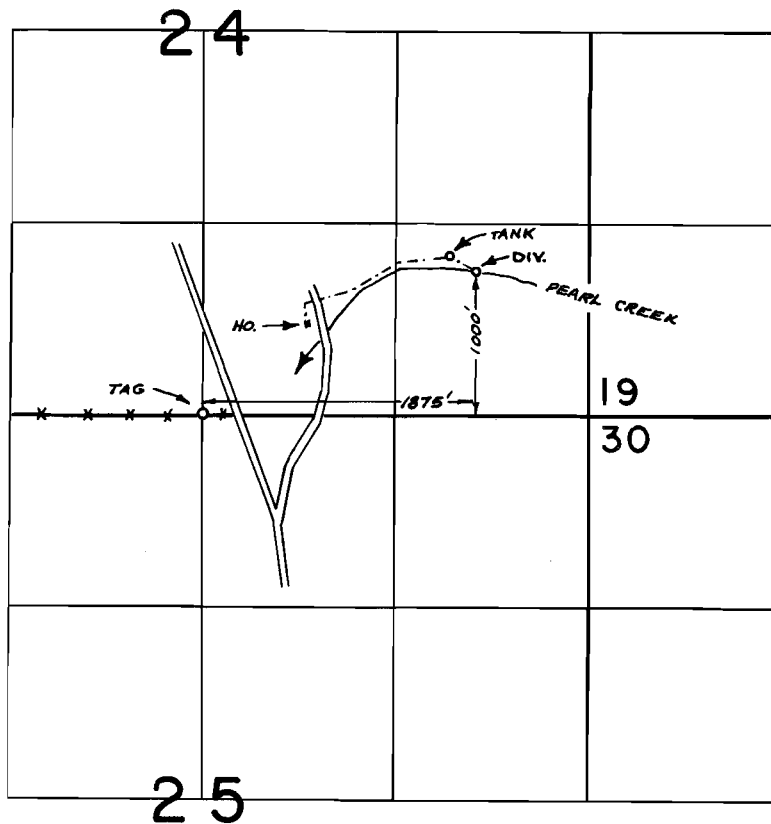

FINAL PROOF SURVEY
UNDER

Application No. 48381 Permit No. 36322
IN NAME OF

ALBERT L. MOORES

Surveyed MAY 2 1973, by R. MUCKEN