

T.3N. R.28E. W.M.

6-5500

76727


41252

SUPERSEDED BY

Cont. 76726

W113111

V.55 P.36

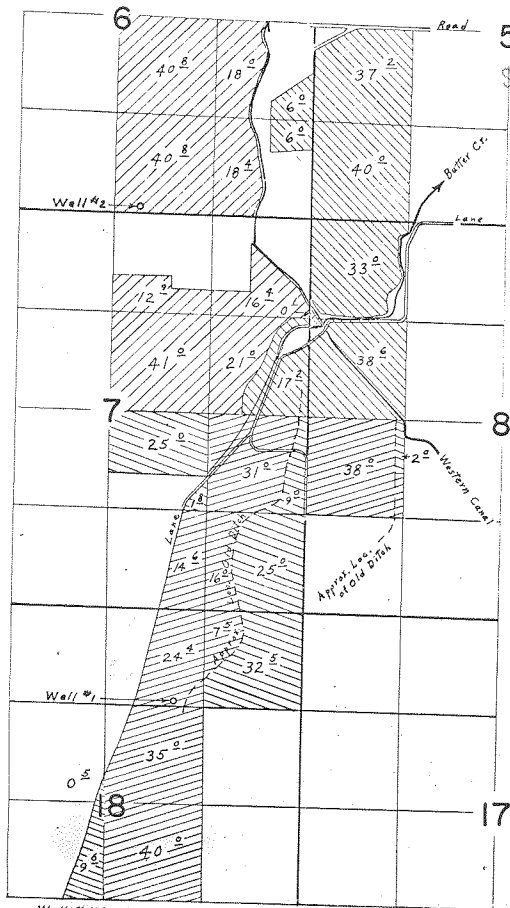

Well #1 located 1220' S. & 1760' W. from N.E. Corner Section 18  
 Well #2 located 80' N. & 350' E. from S. & Corner Section 6

- Well #1 Primary
- Well #1 Supplemental
- Well #2 Primary
- Well #2 Supplemental




STONE MACHINERY CO.

IN NAME OF

Application No. 5-3939 Permit No. G-3530

UNDER

FINAL PROOF SURVEY




