


G-3582
G-4356

41253
41256

T4N.R34&35E, T3N.R35E.WM

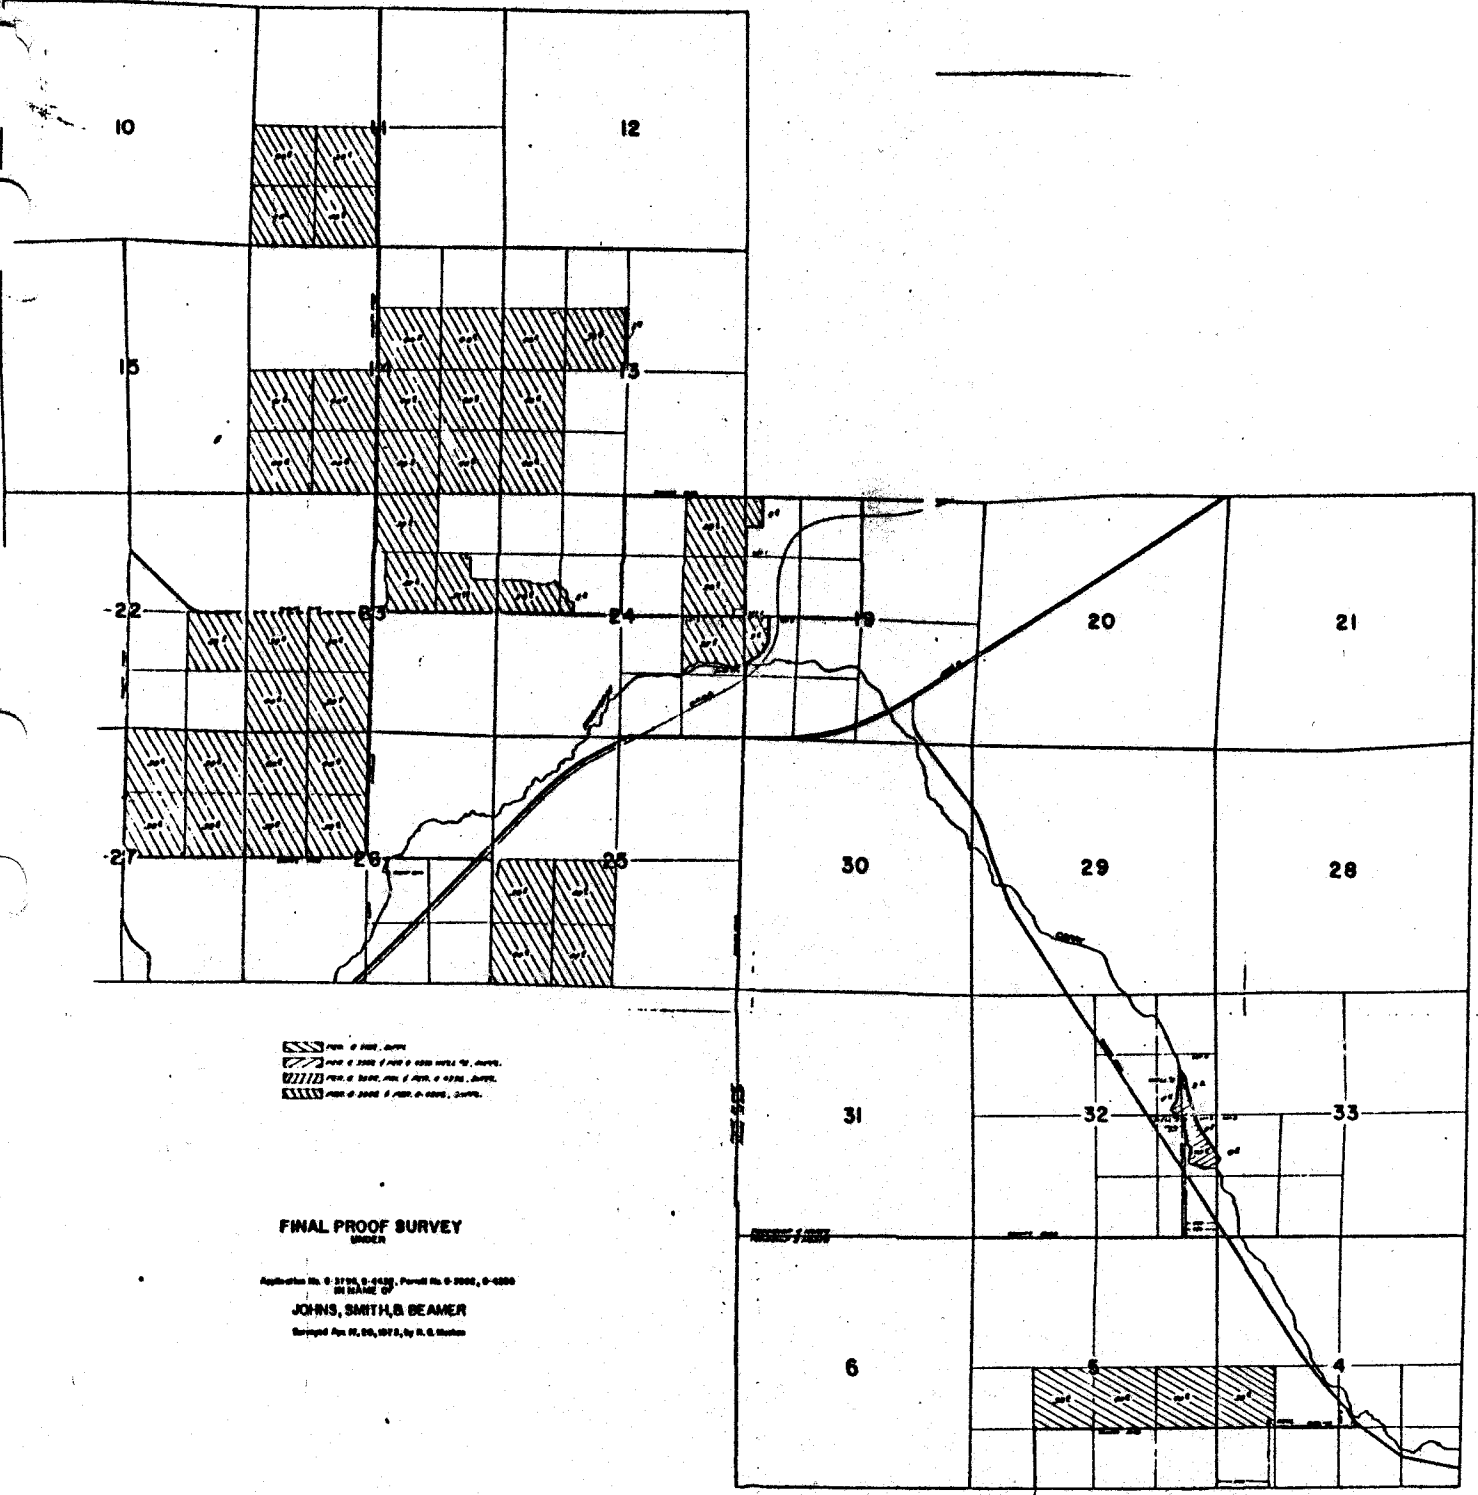

FINAL PROOF SURVEY

BY NAME OF
JOHNS, SMITH & BEAMER
Surveyed Apr. 17, 20, 1872, by R. G. Stanton