


T.2N.R.31E.W.M.

G-3742
41254

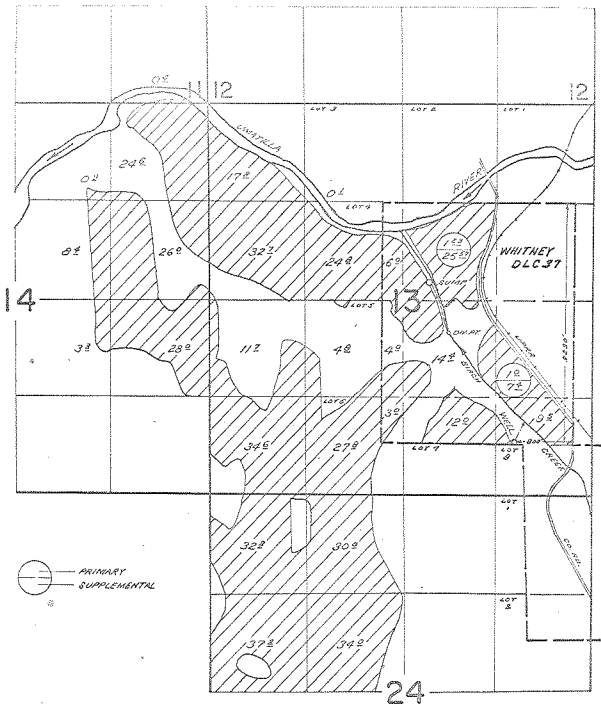

FINAL PROOF SURVEY
UNDER

Application No. G-3965 Permit No. G-3742
IN NAME OF

JOHNS, SMITH, & BEAMER

Surveyed Apr. 20 1973, by D.M. Norgy