


G-3950
41255

T. 2 N. R. 33 E. W. M.

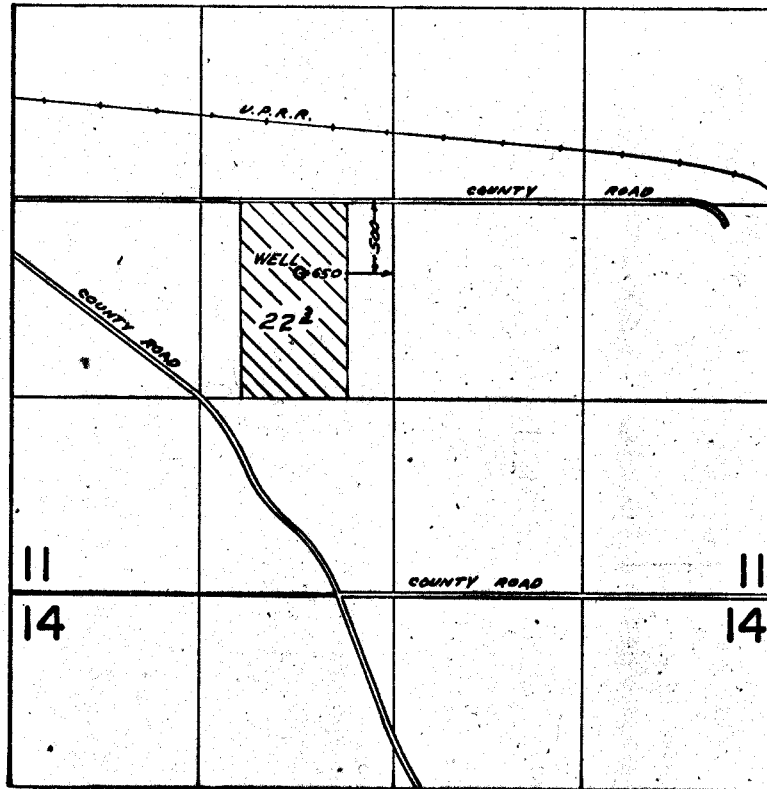

FINAL PROOF SURVEY UNDER

Application No. G-4181 Permit No. G-3950
IN NAME OF

VERNON R. CASE

Surveyed Apr. 16 1973, by D.M. Norex