


G-3582
G-4356

41256

T4NR.34E35E, T.3NR.35E.WM

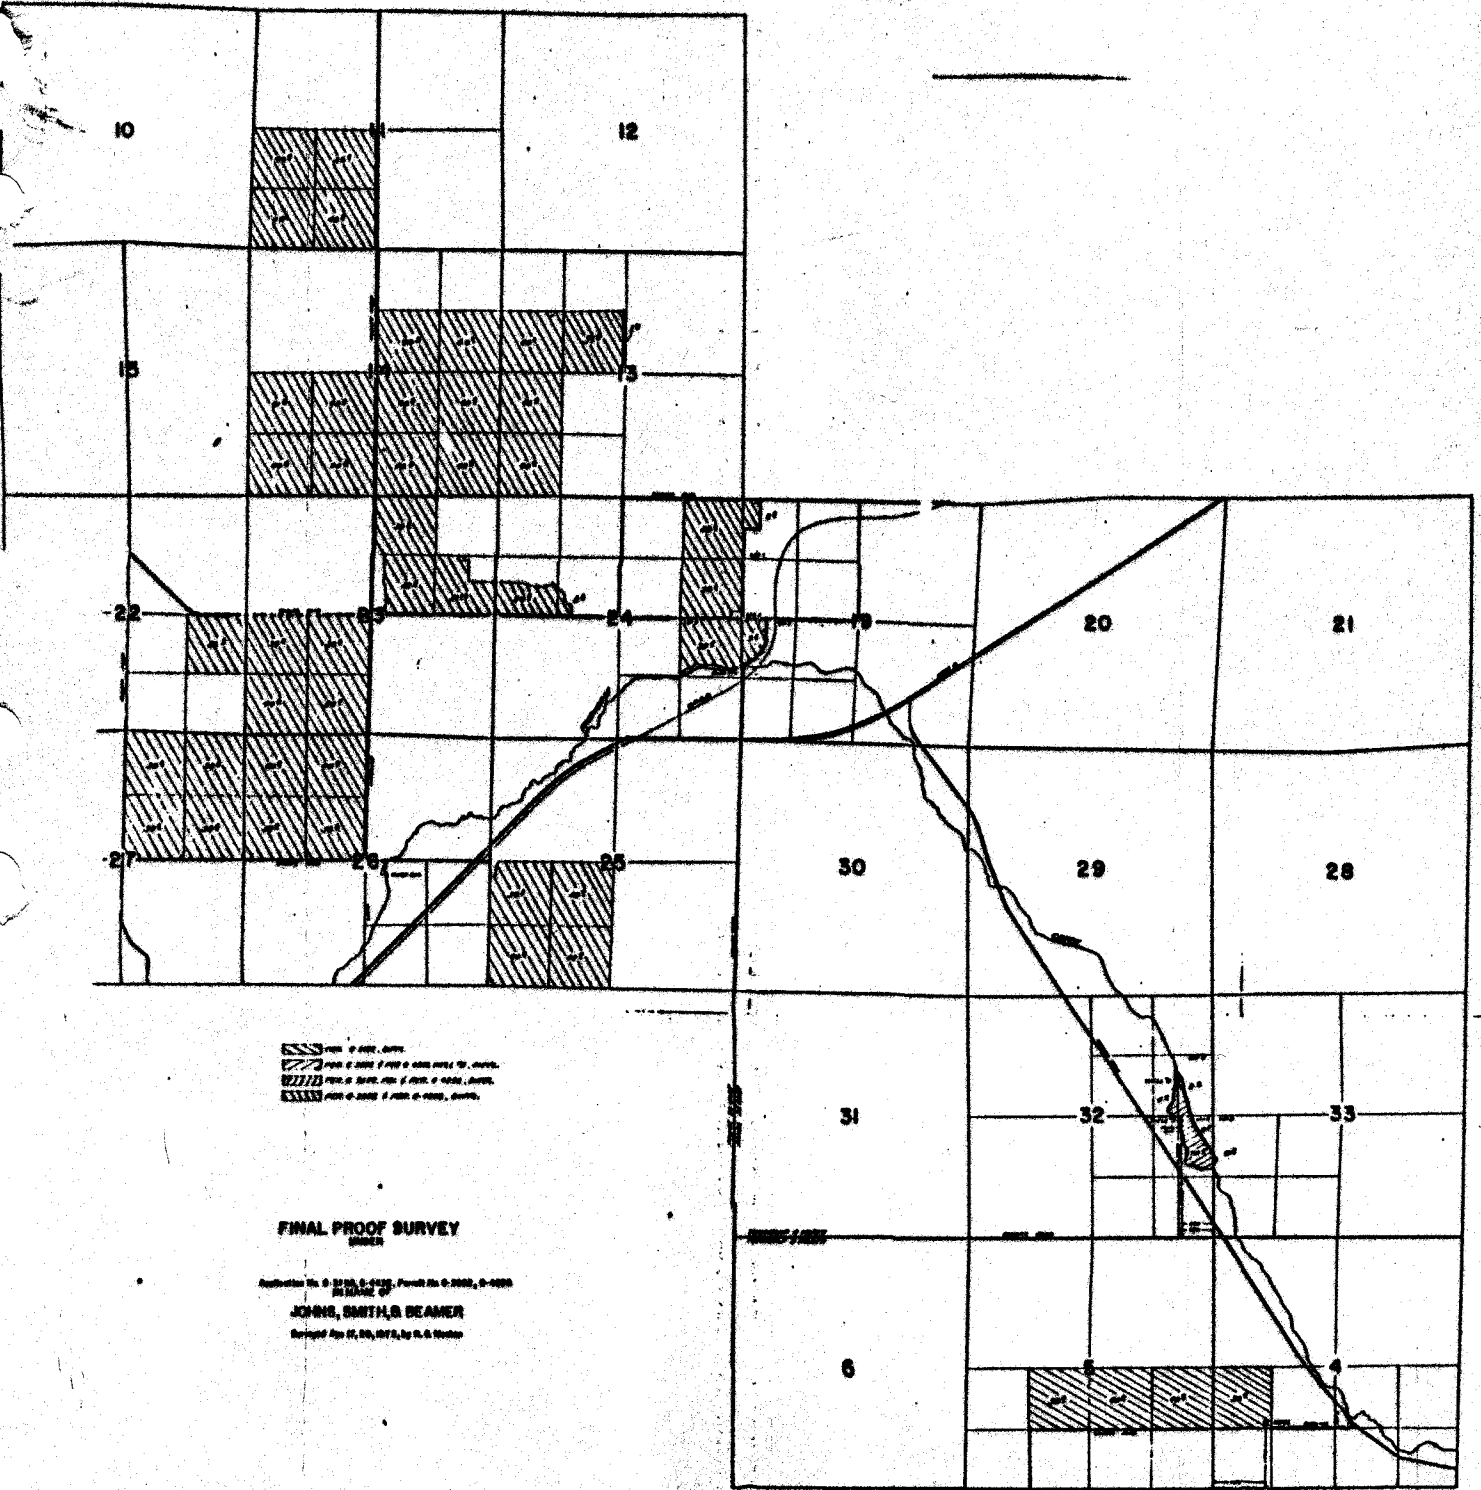


FINAL PROOF SURVEY


JOHNS, SMITH & BEAMER
