


G-4630  
41257

T.6N.R.35E.W.M.

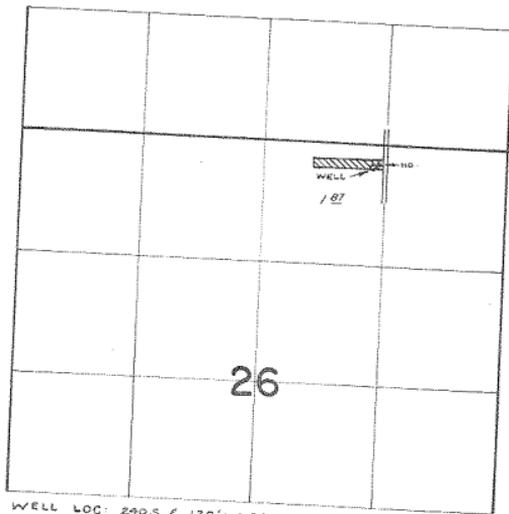

WELL LOC: 290 S. & 120' W. FROM NE COR. NW & NE  $\frac{1}{4}$  SEC. 26

**FINAL PROOF SURVEY**  
UNDER

Application No. G-4919 Permit No. G-4630  
IN NAME OF

Denis L. & Mary A. Goo

Surveyed APR. 9, 1977, by R. MUCKEN