


T. 3 N. R. 35 E. W. M.

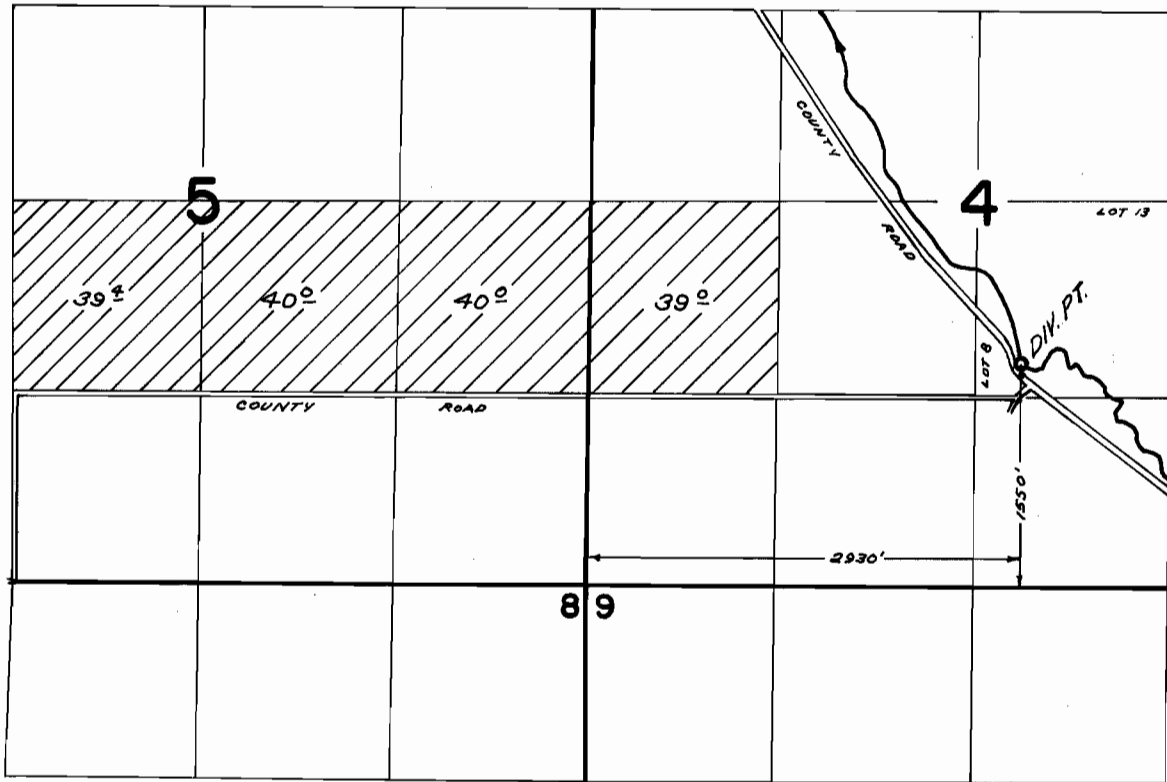

FINAL PROOF SURVEY
UNDER

Application No. 41017 Permit No. 30581
IN NAME OF

JOHNS. SMITH, AND BEAMER

Surveyed APR. 17 19 73, by R. G. MUCKEN