


T.4N.,R.34E.,W.M.

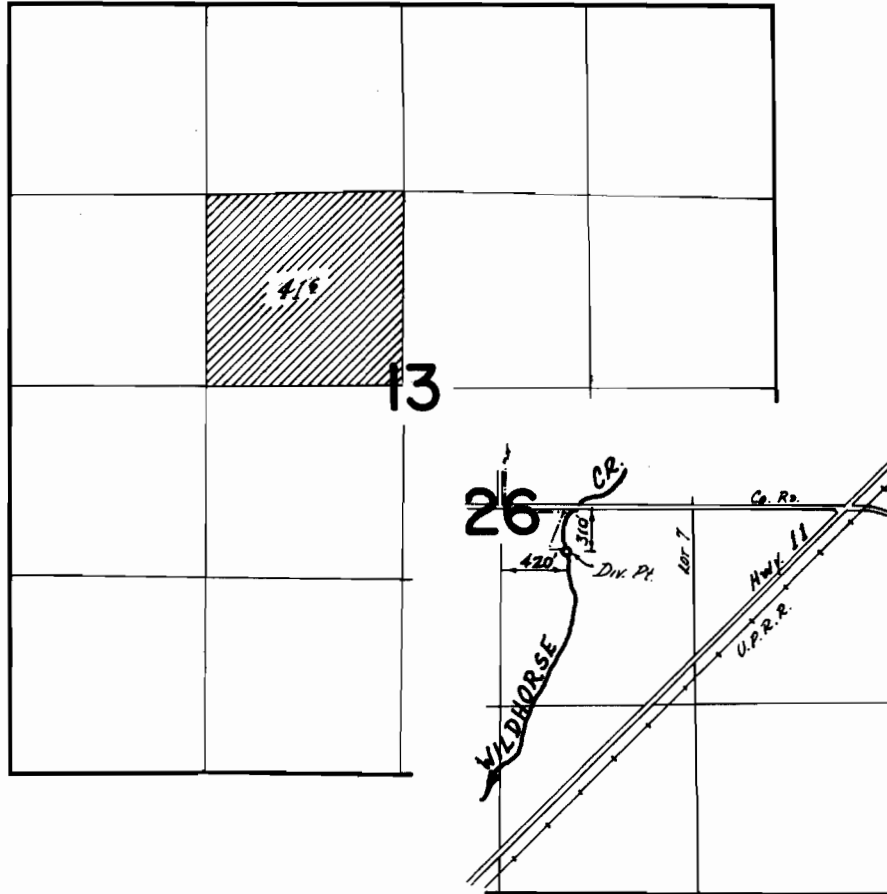

**FINAL PROOF SURVEY**  
UNDER

Application No. 43234 Permit No. 32322  
IN NAME OF

JOHNS, SMITH, & BEAMER

Surveyed April 17-20 1973, by R. G. MUCKEN